


T. 7 S. R. 39 E. W.M.

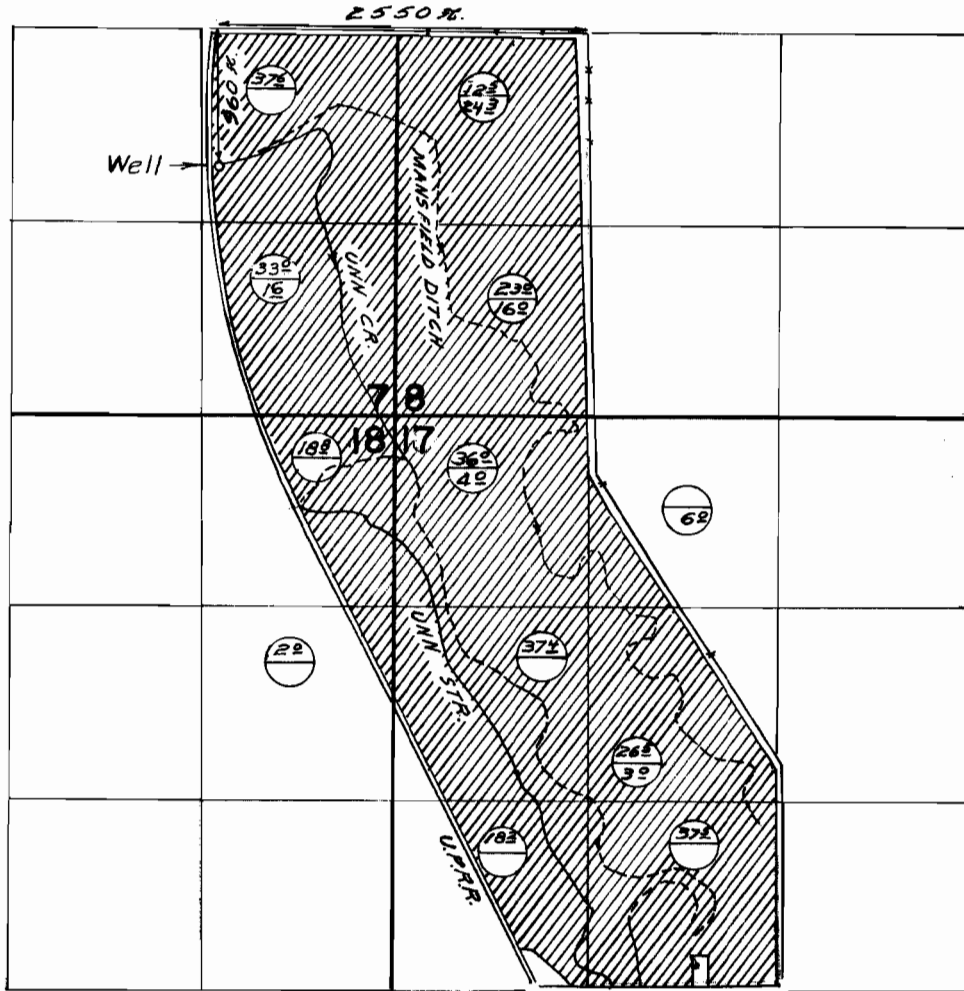

○ Supplemental
○ Primary

FINAL PROOF SURVEY UNDER

Application No. G-2473 Permit No. G-2329
IN NAME OF

OTTO WENDT & SONS

Surveyed Aug 8, 1966, by W. J. Ruppert