


T.12 S.R.6 W. W.M.

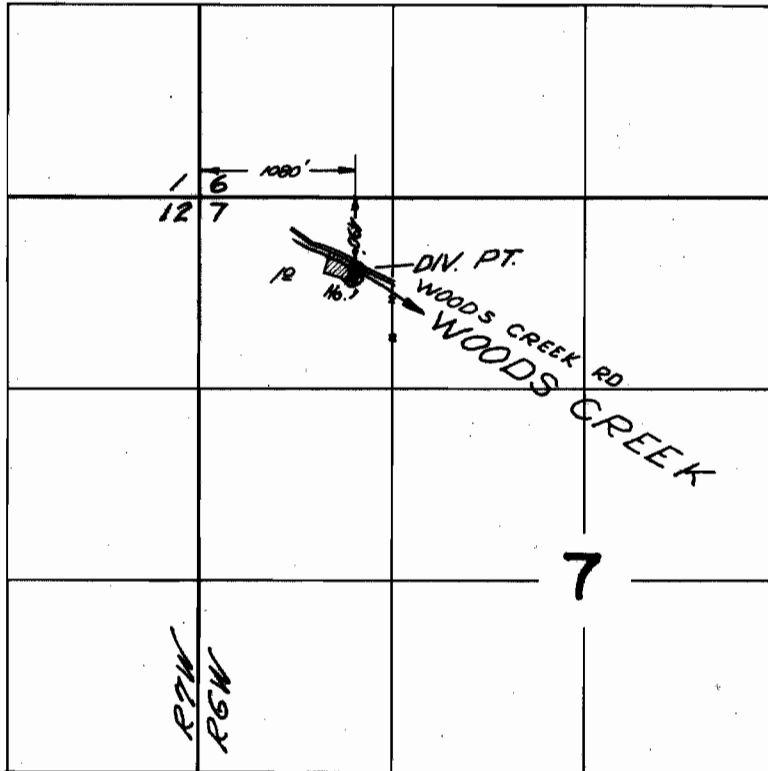

FINAL PROOF SURVEY
UNDER

Application No. 38940 Permit No. 28975
IN NAME OF

LEO N. and CARMEN LUND

Surveyed April 26 1966, by V. GARNER.