


# T. 12 S. R. 5 W. W.M.

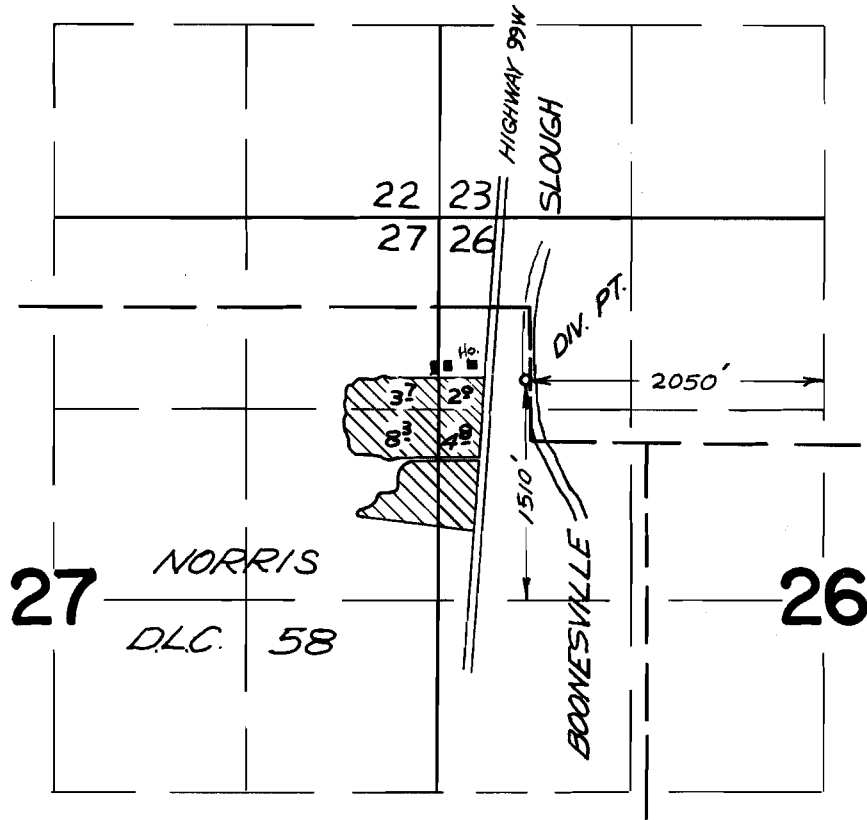

## FINAL PROOF SURVEY UNDER

Application No. 40653 Permit No. 30285  
IN NAME OF

ALBERT ROY MURPHY

Surveyed May 2 1966 by V. GARNER