


T.2S.R.3E.W.M.

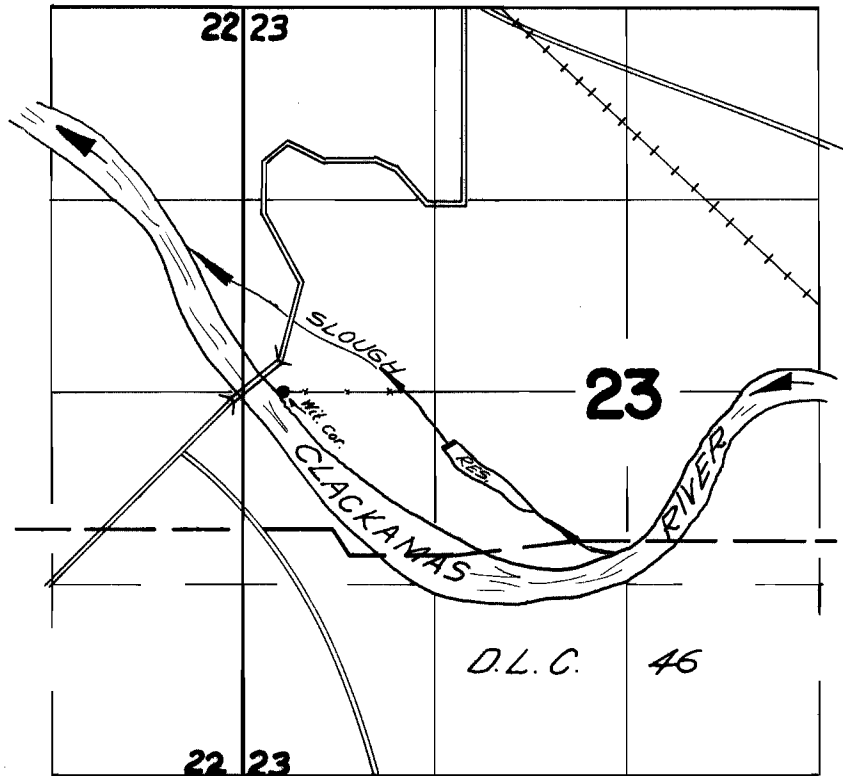

Div. Pt. located 1410 ft. E. & 370 ft. S. from the
W. 1/4 Cor. Sec. 23

FINAL PROOF SURVEY UNDER

R 39105 R 3695
Application No. 39023 Permit No. 29068
IN NAME OF

CLACKAMAS COUNTY

Surveyed Aug. 22, 1966, by V. GARNER