


# T.2S.R.3E.W.M.

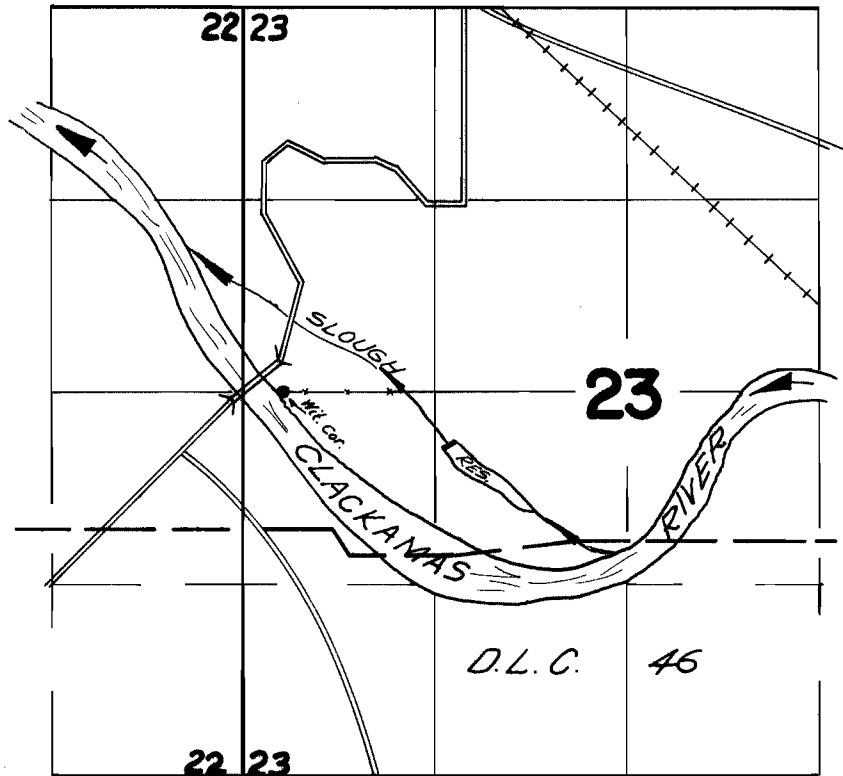

Div. Pt. located 1410 ft. E. & 370 ft. S. from the  
W. 1/4 Cor. Sec. 23

## FINAL PROOF SURVEY UNDER

R 39105                      R 3695  
Application No. 39023    Permit No. 29068  
IN NAME OF

CLACKAMAS COUNTY

Surveyed Aug. 22, 1966, by V. GARNER