


# T.4S.R.1E.82E.W.M:

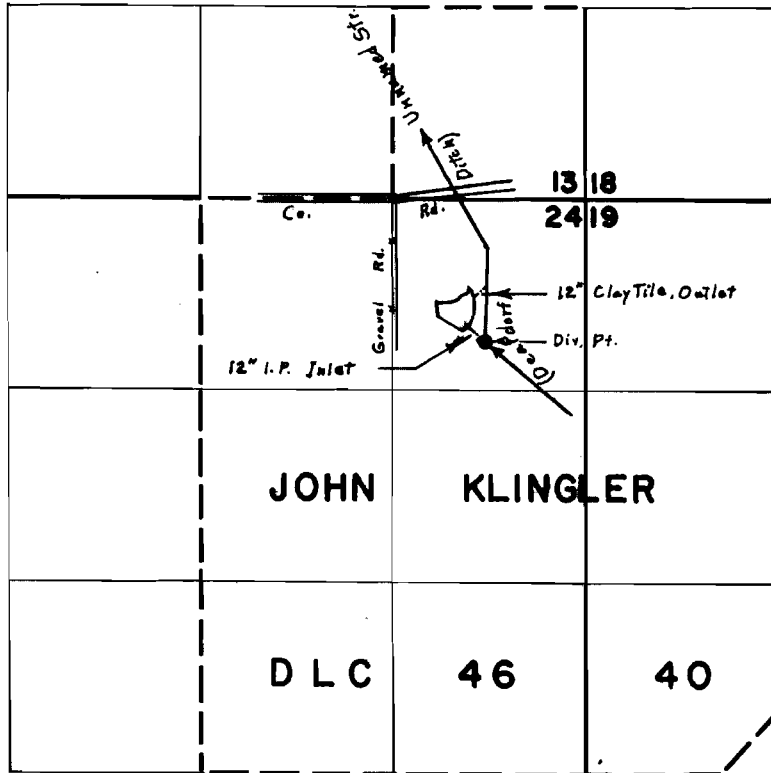

Div. Pt. Located 630' E. & 900' S. From N. W. Cor. N.E.  $\frac{1}{4}$ , N.E.  $\frac{1}{4}$  S. 24

## FINAL PROOF SURVEY UNDER

39323                      29281  
 Application No. ~~R-39322~~ Permit No. ~~R-3899~~  
 IN NAME OF  
 JOHN KOCH

Surveyed Oct. 18, 1966, by *L. E. Small*