


T.4S.R.1E.82E.W.M:

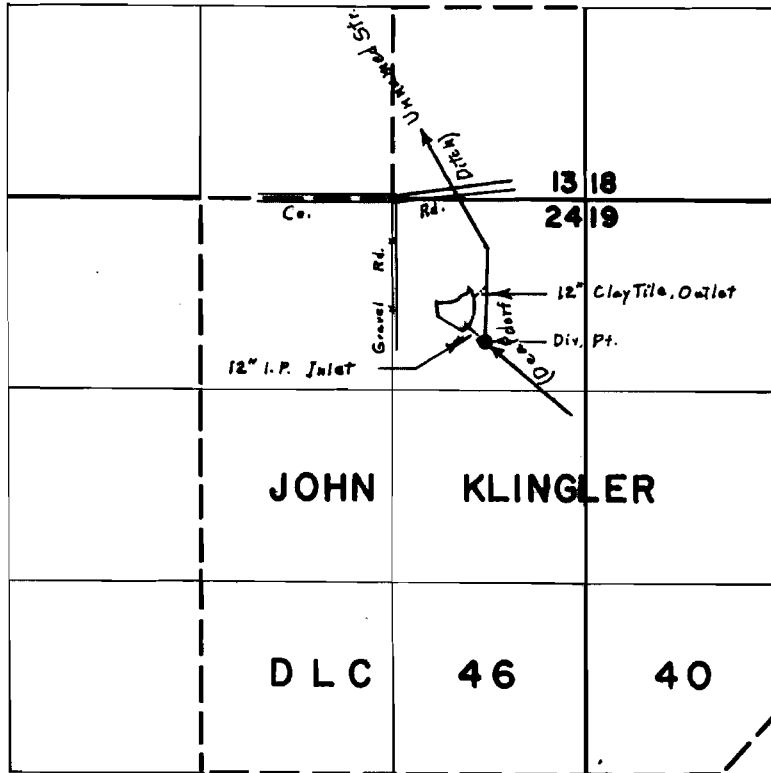

Div. Pt. Located 630' E. & 900' S. From N. W. Cor. N.E. $\frac{1}{4}$, N.E. $\frac{1}{4}$ S. 24

FINAL PROOF SURVEY UNDER

39323 29281
 Application No. R-39322 Permit No. R-3899
 IN NAME OF
 JOHN KOCH

Surveyed Oct. 18, 1966, by L. E. Small