


# T.3S. R.1E. W.M.

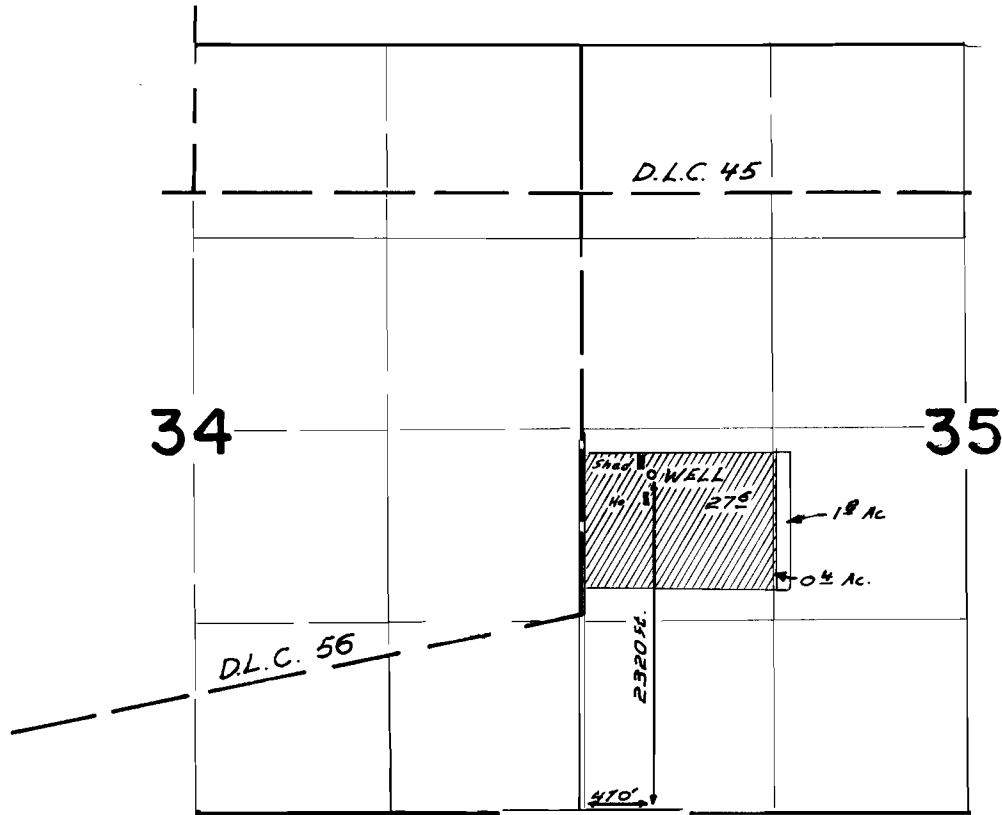

## FINAL PROOF SURVEY UNDER

Application No. G-3058 Permit No. G-2871  
IN NAME OF

Al F. DeForge

Surveyed Oct. 21, 1966, by W. J. Ruppert