


T.2S.R.6E.W.M.

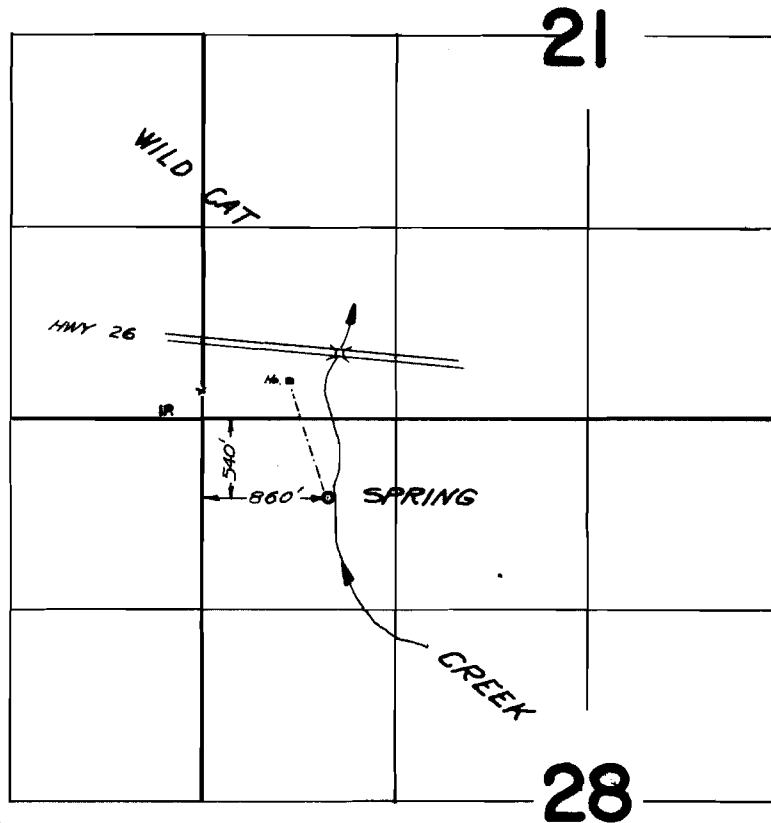

FINAL PROOF SURVEY
UNDER

Application No. 4266.7 Permit No. 30295
IN NAME OF

JOHN C. and EVELYN F. SLOAN

Surveyed Aug 24 1966, by V. GARNER