


T.2S. R.6E. W.M.

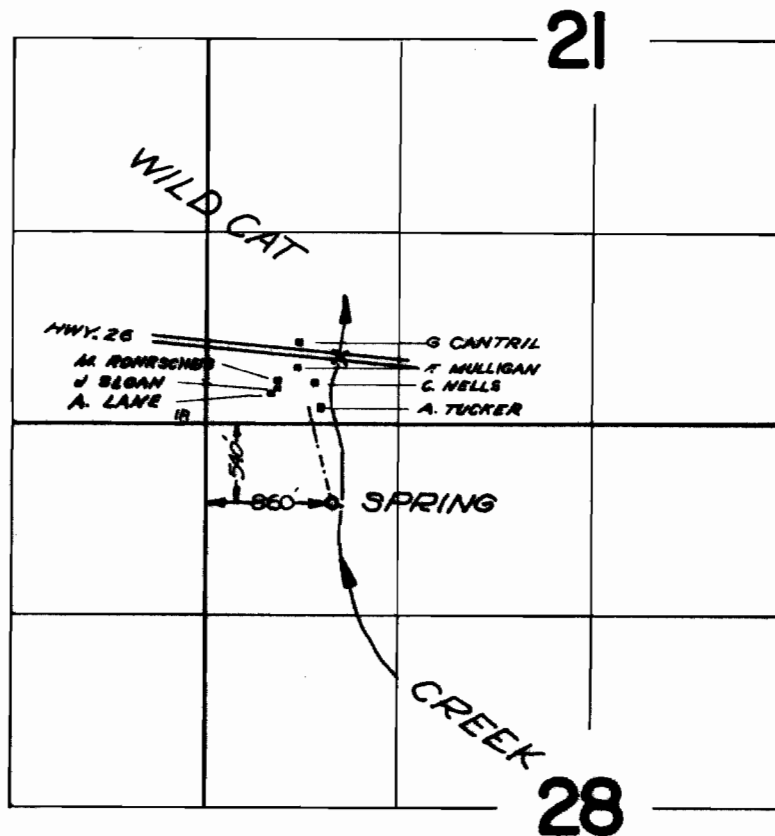

**FINAL PROOF SURVEY**  
UNDER

Application No. 41358 Permit No. 30694  
IN NAME OF  
ARTHUR R. TUCKER, FLOYD MULLIGAN, CARL NELLS  
GLEN CANTRIL, JOHN C. SLOAN, ALICE LANE, MARTHA ROHRSCHEIB

Surveyed Aug. 24 1966, by V. GARNER