


T.29S. R.12W. W.M.

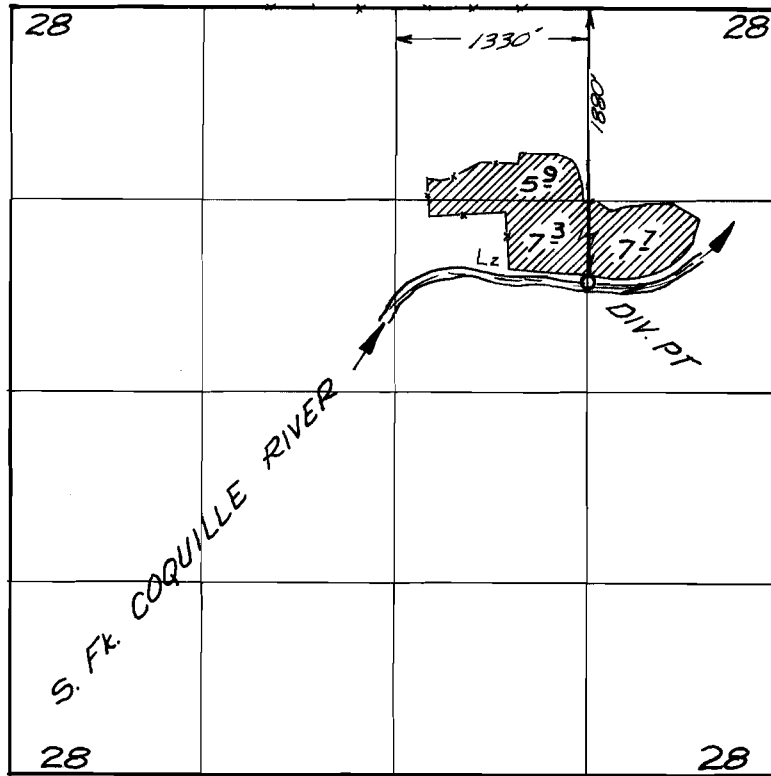

FINAL PROOF SURVEY UNDER

Application No. 40095 Permit No. 29899
IN NAME OF

L. C. DAVENPORT

Surveyed Oct 13, 1966, by V. GARNER.