


T.30S.R.13W.W.M.

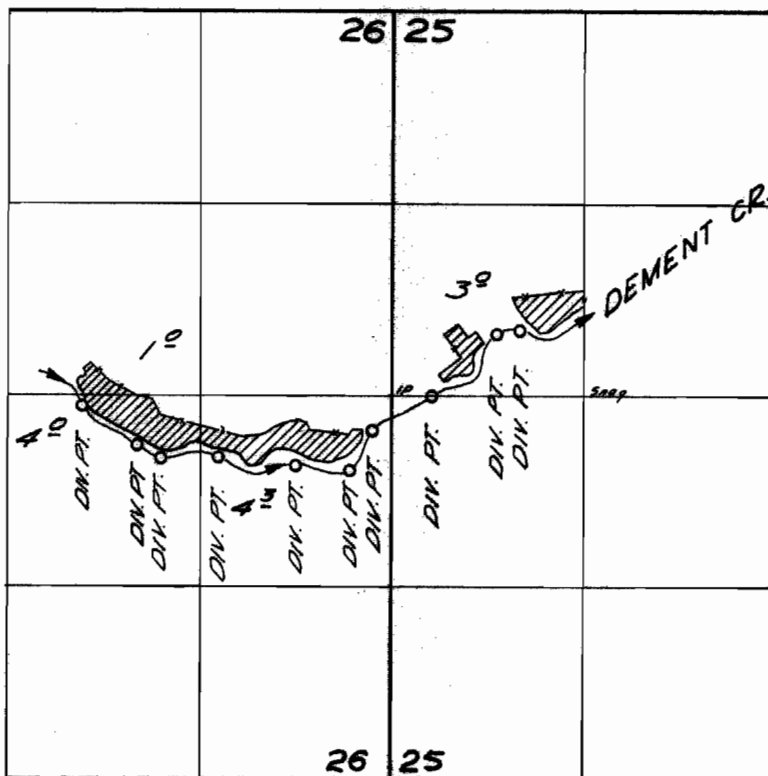

Div. Pts located 70 ft. S. & 2130 ft. W.; 340 ft. S. & 1750 ft. W.;
 430 ft. S. & 1590 ft. W.; 430 ft. S. & 1200 ft. W.; 480 ft. S. &
 660 ft. W.; 520 ft. S. & 290 ft. W.; 230 ft. S. & 130 ft. W.;
 5 ft. N. & 270 ft. E.; 430 ft. N. & 730 ft. E.; 450 ft. N. & 880 ft. E.
 All from the east $\frac{1}{4}$ corner of section 26

FINAL PROOF SURVEY UNDER

Application No. 34457 Permit No. 27046
 IN NAME OF

GLEN D. EYMEN

Surveyed Oct. 7, 1965, by V. GARNER