


T.29S. R.12 W. W.M.

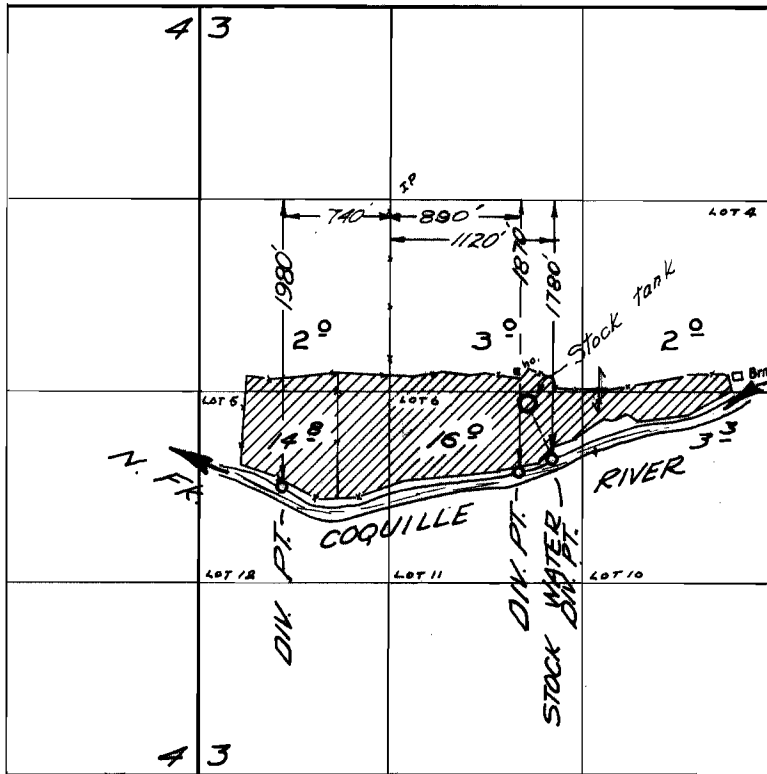

FINAL PROOF SURVEY UNDER

Application No. 39526 Permit No. 29406
IN NAME OF

HENRY GASNER

Surveyed Oct. 7, 1966, by V. GARNER