


T.29S. R.12 W. W.M.

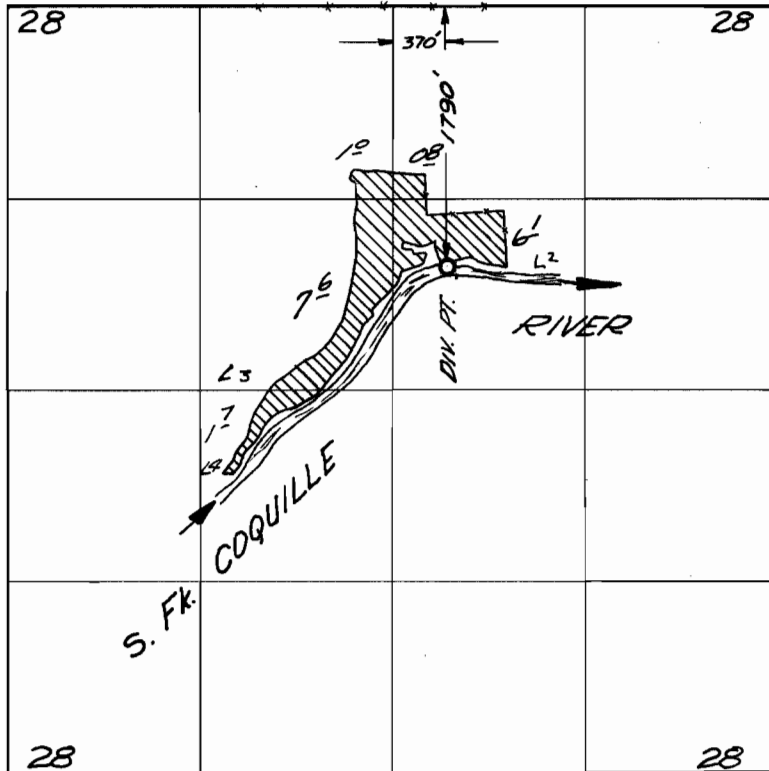

FINAL PROOF SURVEY UNDER

Application No. 40436 Permit No. 30193
IN NAME OF

WALDO D. McNAIR

Surveyed Oct. 13, 1966, by V. GARNER