


T.30S.R.13 W. W.M.

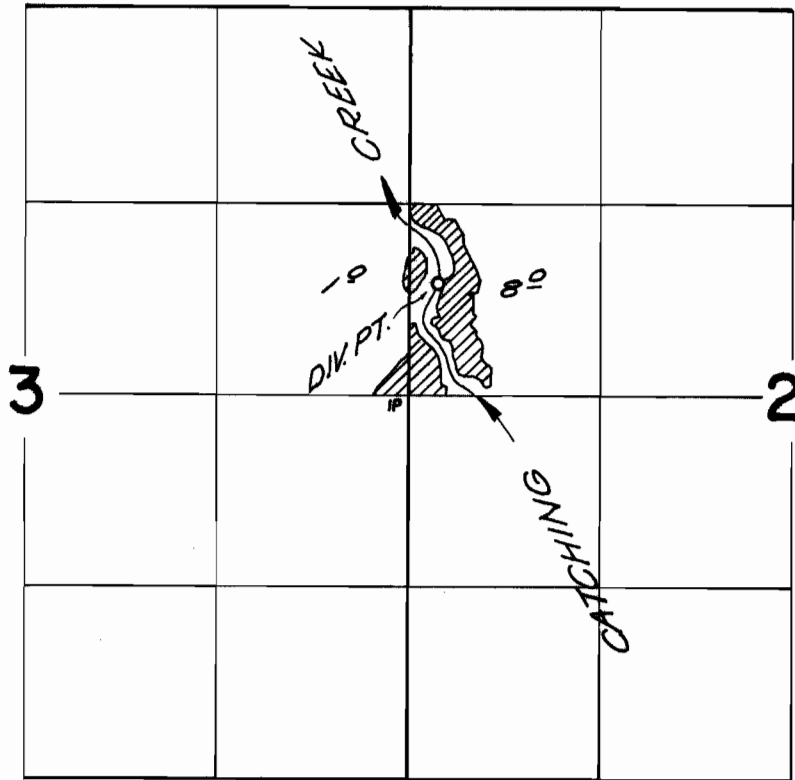

DIV PT LOCATED 770 ft. N. and 200 ft. E.  
FROM THE WEST  $\frac{1}{4}$  CORNER OF SECTION 2

**FINAL PROOF SURVEY**  
UNDER

Application No. 38308 Permit No. 28574  
IN NAME OF

FARRELL RANKIN

Surveyed OCT 10, 1966, by V. GARNER