
## T.30S. R.12 W. W. M.

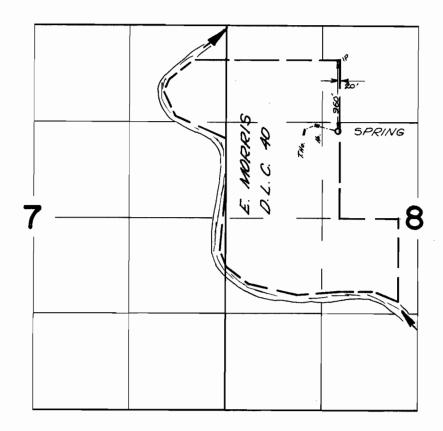

## FINAL PROOF SURVEY

Application No. 39793 Permit No. 29773 IN NAME OF	
ERNEST M. WILKINS	
Surveyed Oct 4	1966. by V. GARNER