


T.29 S. R.11 W. W.M.

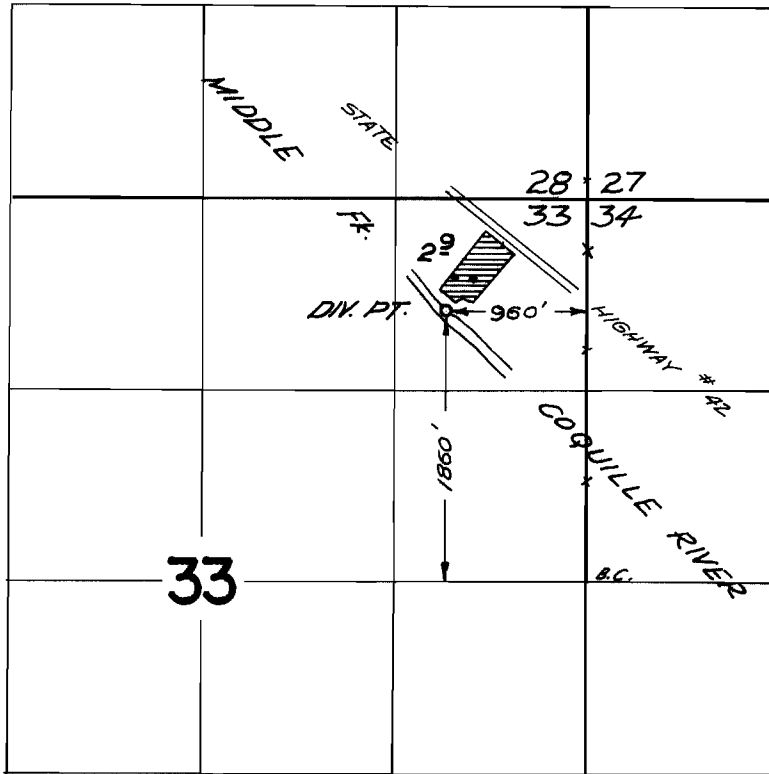

FINAL PROOF SURVEY UNDER

Application No. 39866 Permit No. 29674
IN NAME OF

GEORGE A. YOUNG

Surveyed Oct. 13 1966, by V. GARNER