


T.35 & 36 S. R.14 W. W. M.

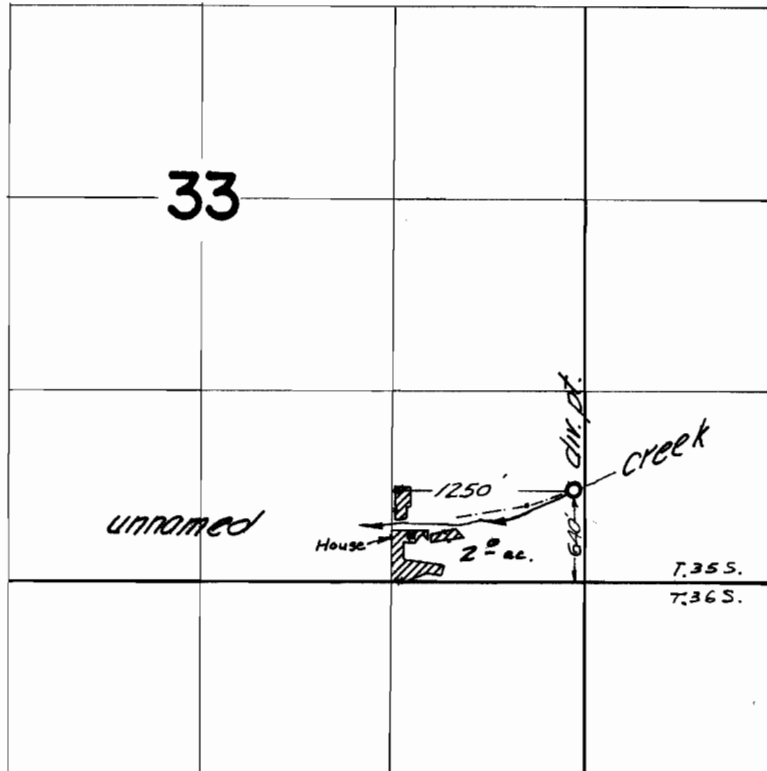

FINAL PROOF SURVEY
UNDER

Application No. 39216 Permit No. 29192
IN NAME OF

R. L. BAILOR

Surveyed Sept. 19 1966, by V. GARNER