


T. 41 S. R. 13 W. W.M.

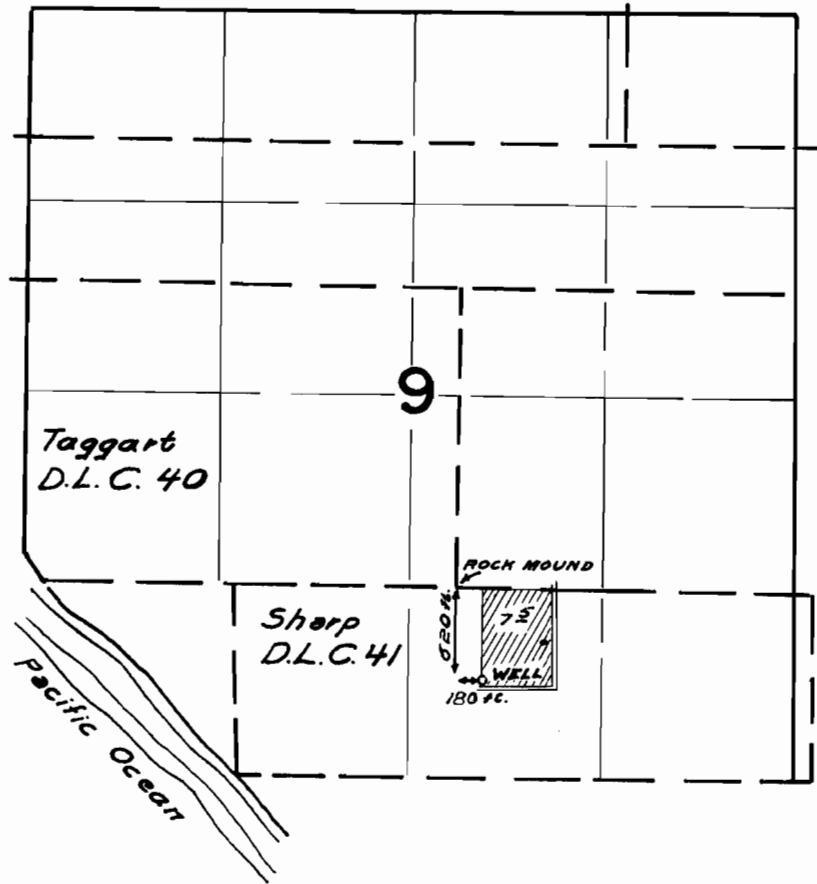

FINAL PROOF SURVEY
UNDER

Application No. G-2697 Permit No. G-2493
IN NAME OF

Minnie Clendenin

Surveyed Sept 15 1966, by W. J. R.