


# T. 41 S. R. 13 W. M.

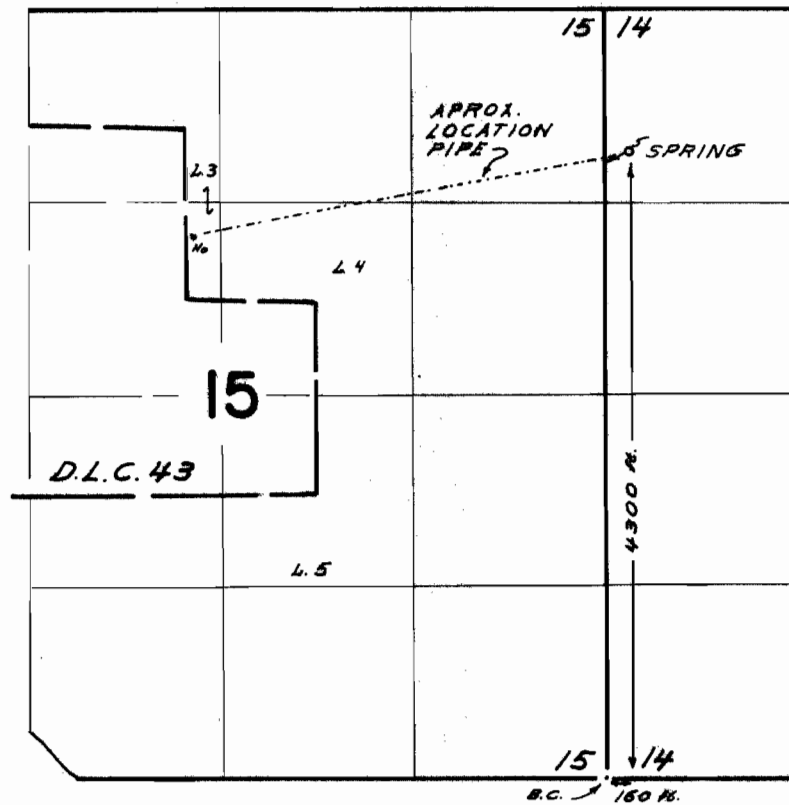

## FINAL PROOF SURVEY UNDER

Application No. 39772 Permit No. 29686  
IN NAME OF

Gene Colagrove

Surveyed Sept. 20 1966, by W. J. Ruppert