


T. 32 S. R. 15 W. W. M.

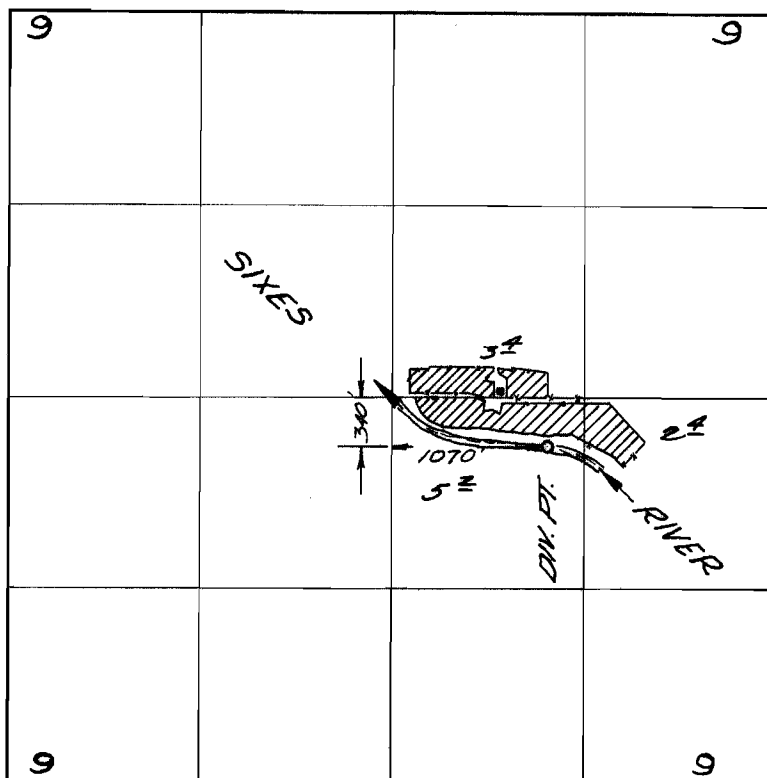

FINAL PROOF SURVEY UNDER

Application No. 40049 Permit No. 29975
IN NAME OF

SAM and VIOLA CLATT

Surveyed Sept. 13 1966, by V. GARNER