


T. 40S. R. 13W. W.M.

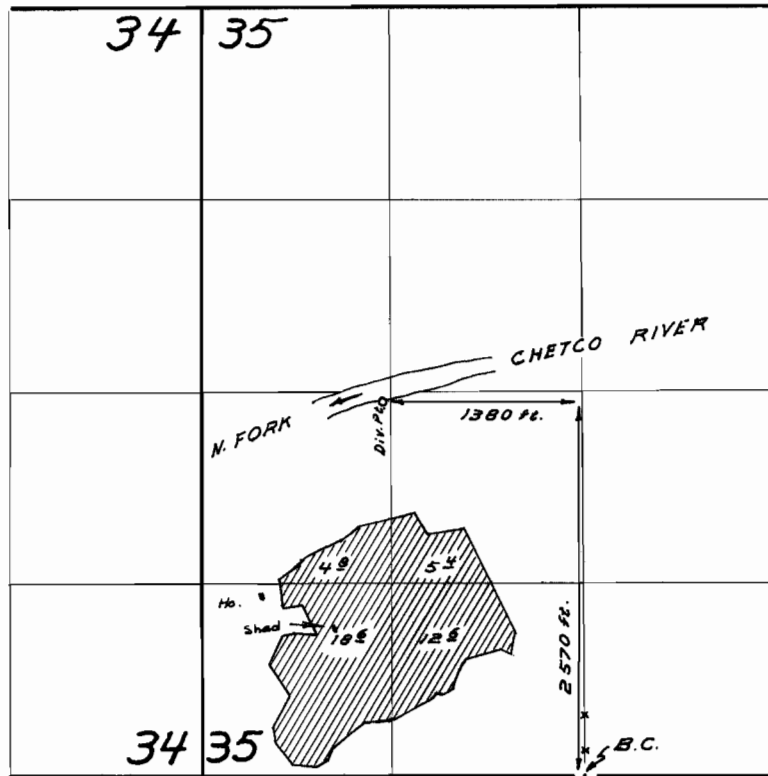

FINAL PROOF SURVEY
UNDER

Application No. 37282 Permit No. 27928
IN NAME OF

Theodore L. Freeman

Surveyed Sept 16 1966, by W. J. Ruppert