


T.40S. R.14 W.W.M.

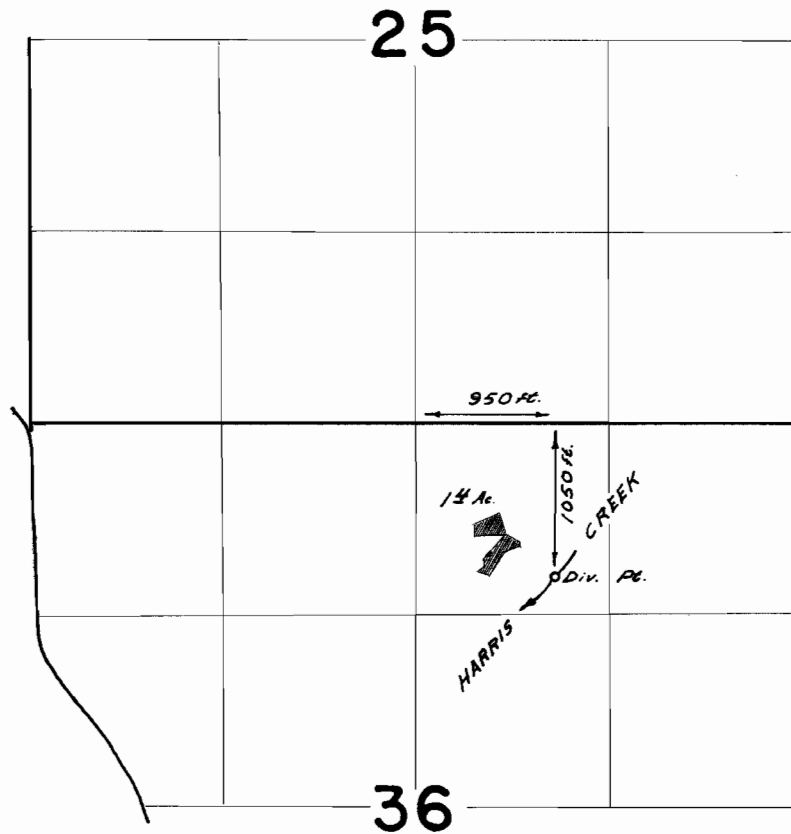

FINAL PROOF SURVEY
UNDER

Application No. 40490 Permit No. 30171
IN NAME OF

Alvilda H. Gardner

Surveyed Sept 13 1966, by W.J. Ruppert