


T.36 & 37 S. R.14 & 15 W. W.M.

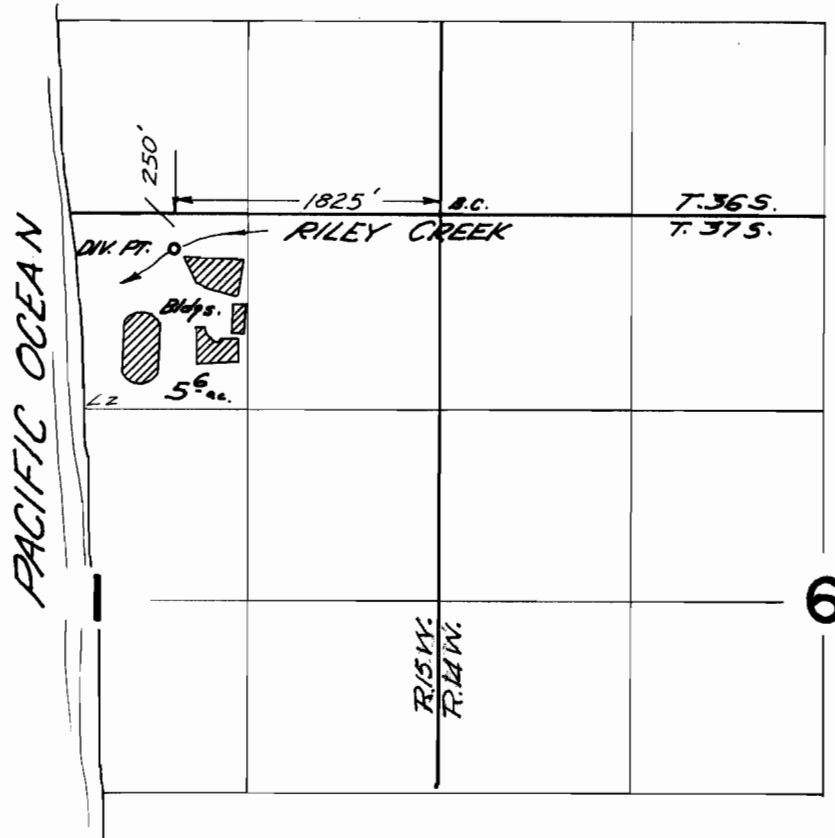

FINAL PROOF SURVEY
UNDER

Application No. 37562 Permit No. 27987
IN NAME OF

GOLD BEACH UNION HIGH SCHOOL DIST #1

Surveyed Sept. 20 19.66, by V. GARNER