


T. 41 S. R. 13 W. W. M.

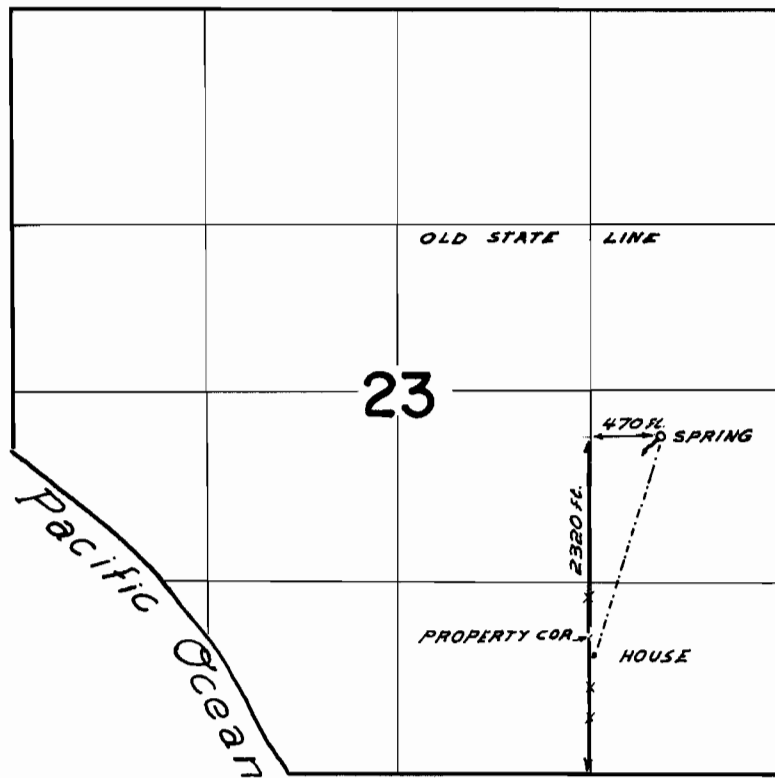

FINAL PROOF SURVEY
UNDER

Application No. 40969 Permit No. 30552
IN NAME OF

RUSSELL L. JENKINS & RUTH JENKINS

Surveyed Sept. 9 1966, by W. J. Ruppert