


T.38S. R.14W.W.M.

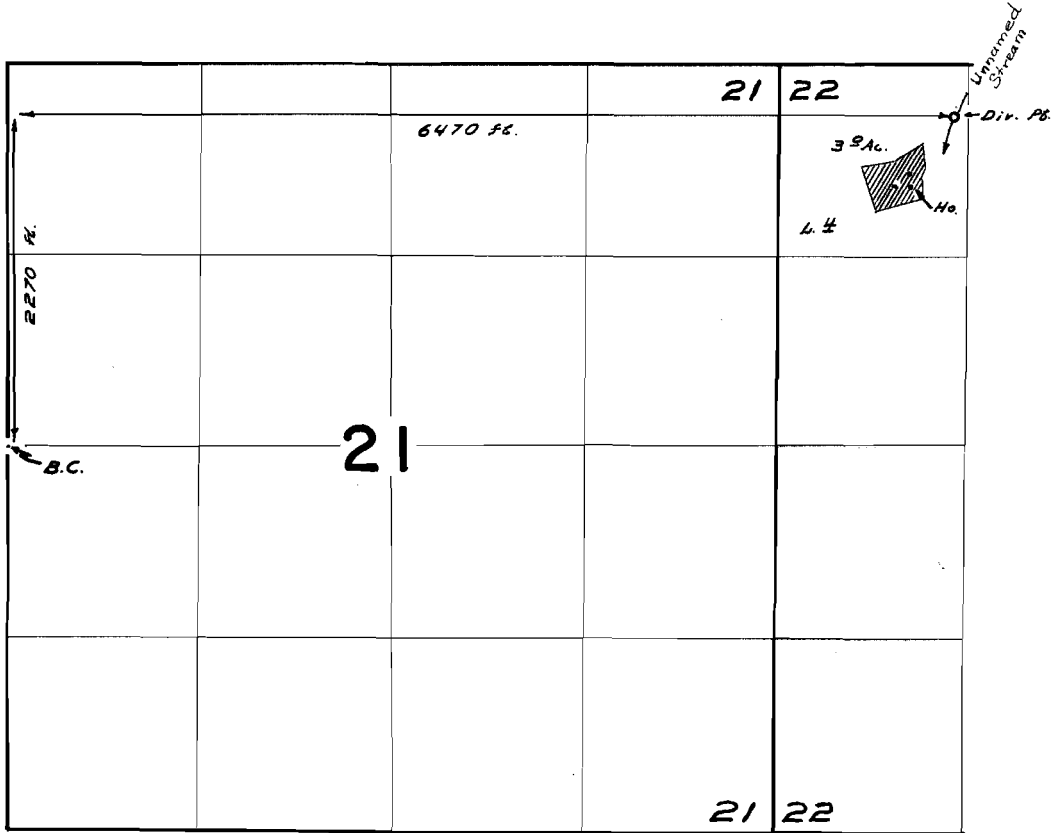

FINAL PROOF SURVEY UNDER

Application No. 39947 Permit No. 29731
IN NAME OF

Kenneth W. Miller

Surveyed Sept 19 1966, by W. J. Ruppert