


T.36S. R.14 W. W. M.

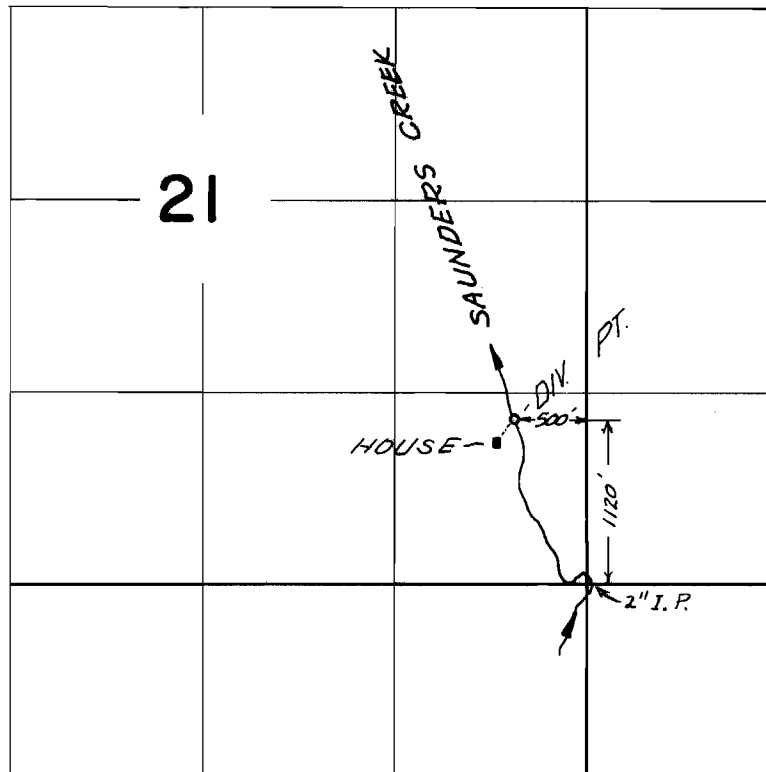

FINAL PROOF SURVEY
UNDER

Application No. 39999 Permit No. 29795
IN NAME OF

RALPH H. NILSSON

Surveyed Sept. 20 1966, by V. GARNER