


T.41S.R.13W.W.M.

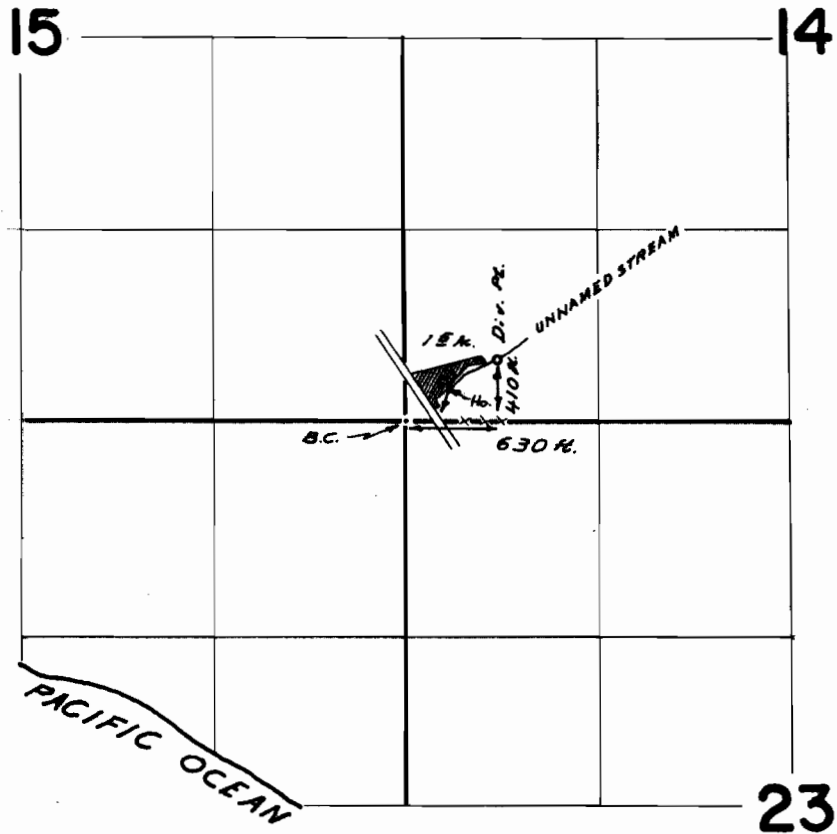

FINAL PROOF SURVEY
UNDER

Application No. 33254 Permit No. 26291
IN NAME OF

Victor A. & Fay Pomarolo

Surveyed Sept. 20 1966, by N. J. Ruppert