


T. 35 S. R. 14 W. W. M.

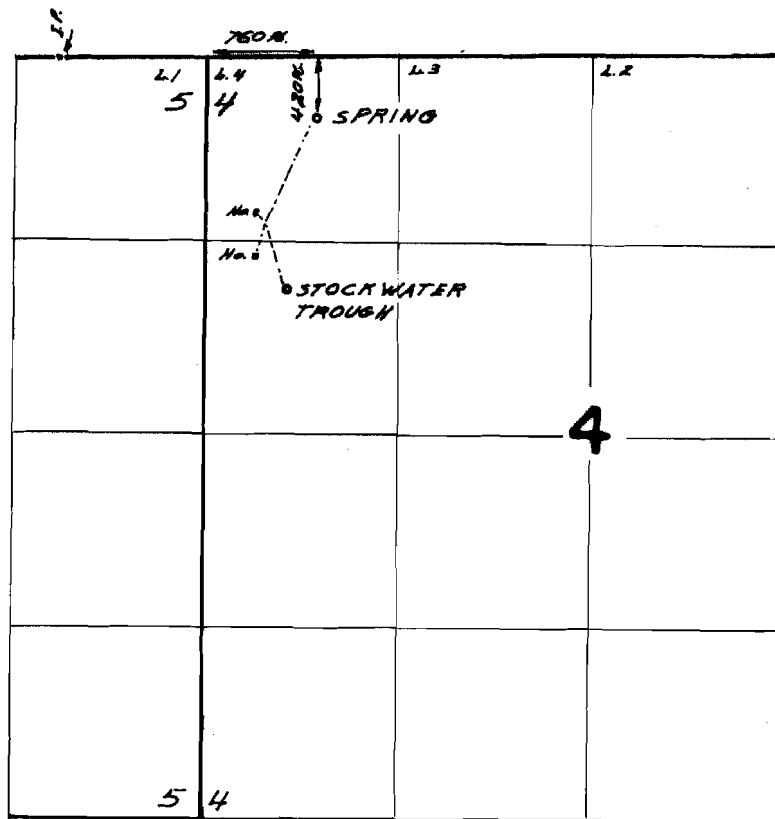

FINAL PROOF SURVEY
UNDER

Application No. 41563 Permit No. 31004
IN NAME OF

James D. Richardson

Surveyed Sept 22 1966, by W. J. Ruppert