


# T.39 S. R.12 W.W.M

20

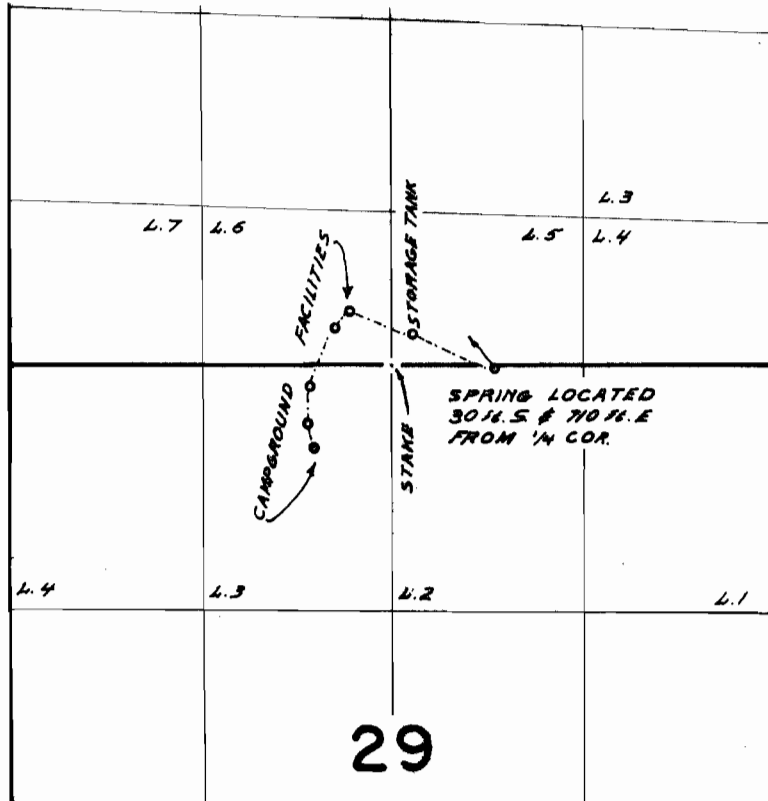

## FINAL PROOF SURVEY UNDER

Application No. 39655 Permit No. 29524  
IN NAME OF

USDA, U.S. Forest Service

Surveyed Sept. 15, 1966, by W. J. Ruppert