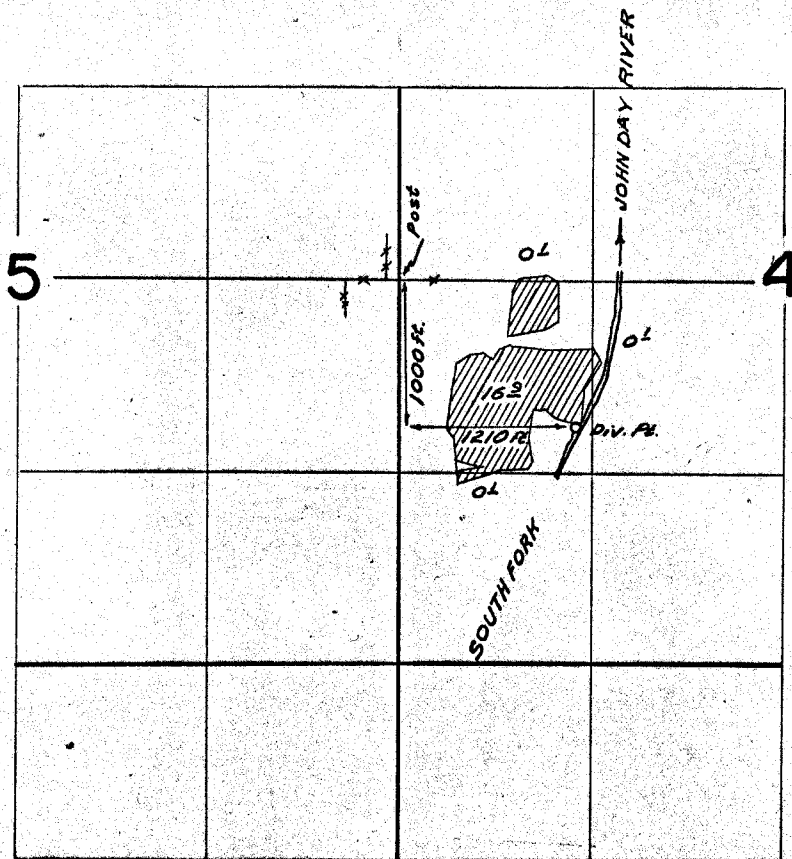


T. 17 S. R. 27 E. W. M.

**FINAL PROOF SURVEY**
UNDERApplication No. 37522 Permit No. 28028
IN NAME OFBonham KeerinsSurveyed July 20 1966, by W. J. Ruppert