


# T.13S. R.33E.W.M.

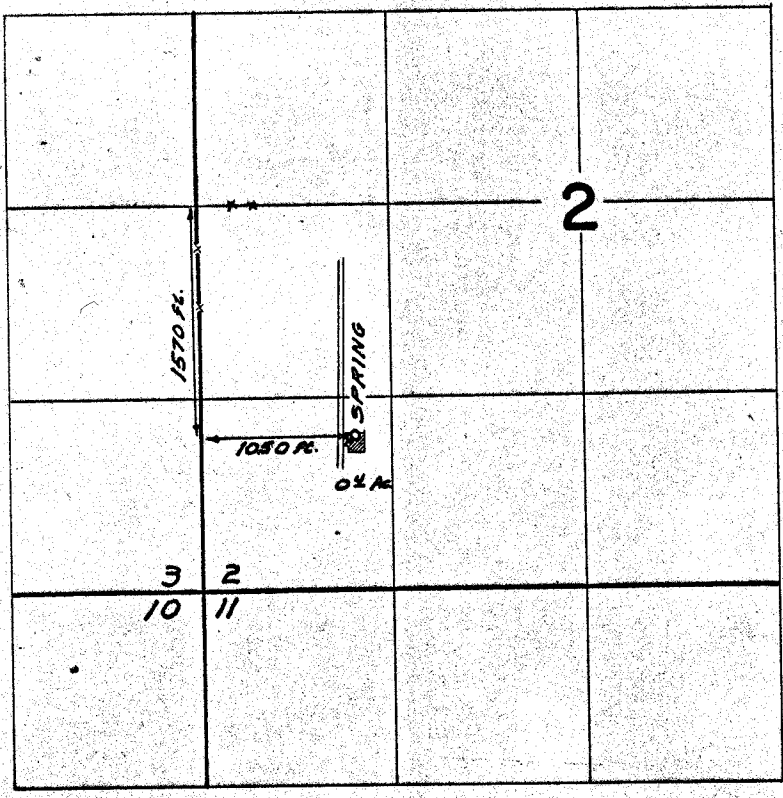

## FINAL PROOF SURVEY UNDER

Application No. 40475 Permit No. 30162  
IN NAME OF

Ira W. & Hilda Kimball

Surveyed July 14, 1966 by W. d. Ruppert