


P 29053 6
34469

T.13S. R.30E. W.M.

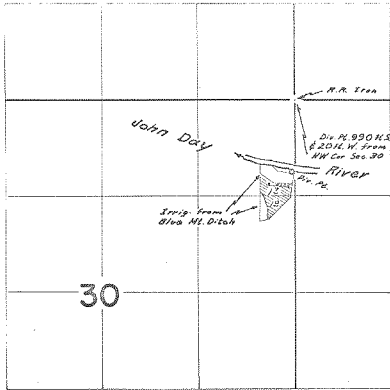

FINAL PROOF SURVEY UNDER

Application No. 39000 Permit No. 29053
IN NAME OF

J. E. & Jossie McKern

Surveyed June 6 1956, by W. J. Ruppert