


T. 13 S. R. 30 E. W. M.

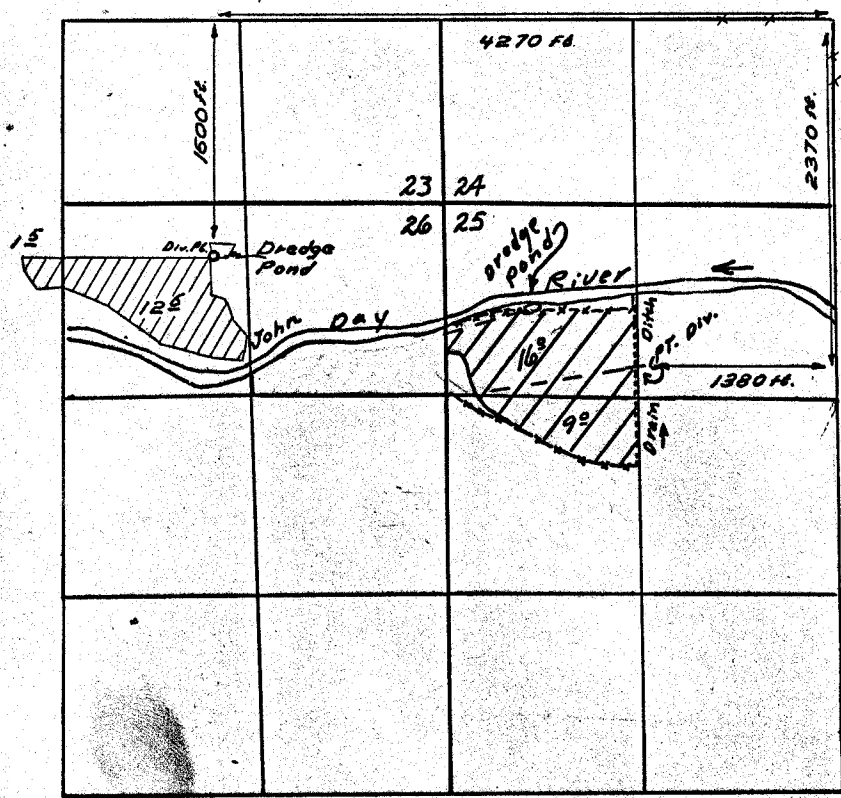

FINAL PROOF SURVEY UNDER

Application No. 38198 Permit No. 29503
IN NAME OF

JOSEPH G. OLIVER

Surveyed 6-25 1965, by G. Ward
7-12 1966 by W. d. Ruppert