


# T.13S. R.33E.W.M

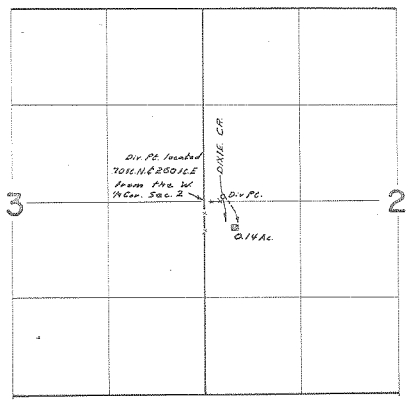

## FINAL PROOF SURVEY UNDER

Application No. 41538 Permit No. 30878  
IN NAME OF

Erma Ross

Surveyed July 13, 1966, by W.V. Ruppert