


T.35S.R.2 W.W.M.

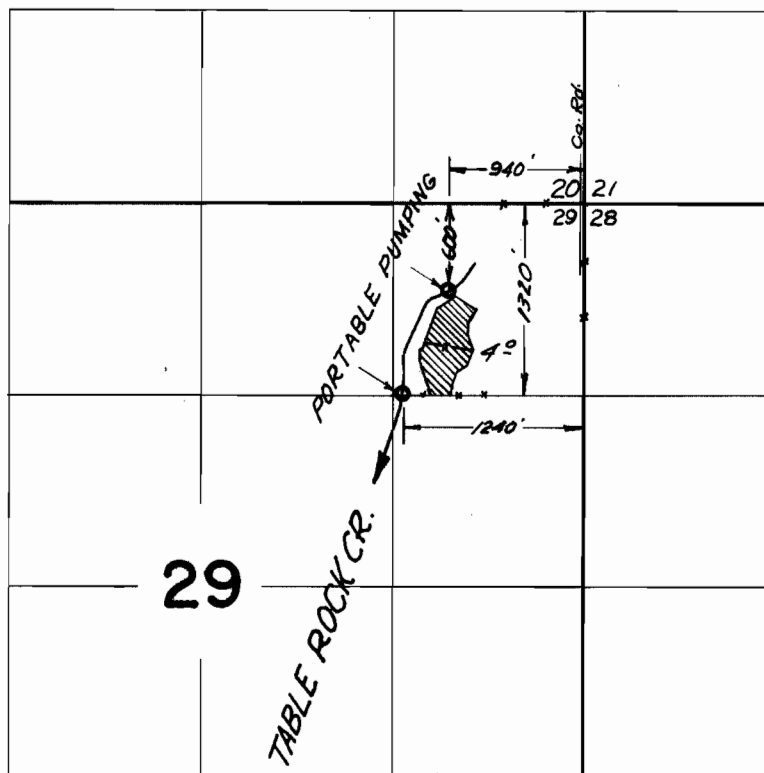

FINAL PROOF SURVEY
UNDER

Application No. 39/68 Permit No. 29/35
IN NAME OF

NADINE R. BAIN

Surveyed July 20 1966, by V. GARNER