


T. 40 & 41 S. R. 3 W. W.M.

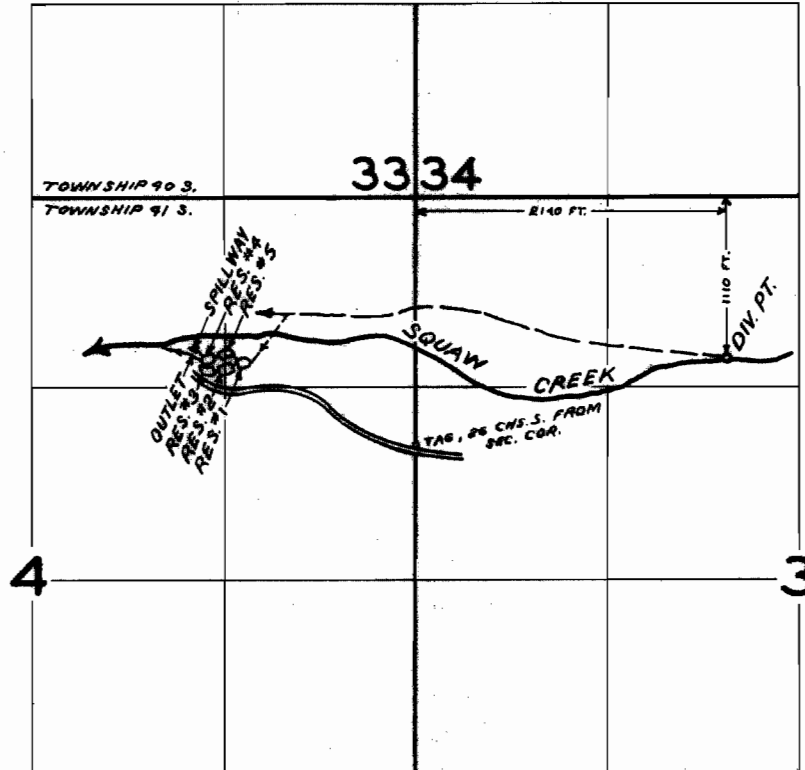

FINAL PROOF SURVEY
UNDER

Application No. R-34493 Permit No. R-2559
34494 27085

IN NAME OF

DIVIDEND BAR

Surveyed JUL. 19 1965, by C. GARDNER