


T. 36 S. R. 1 W. W. M.

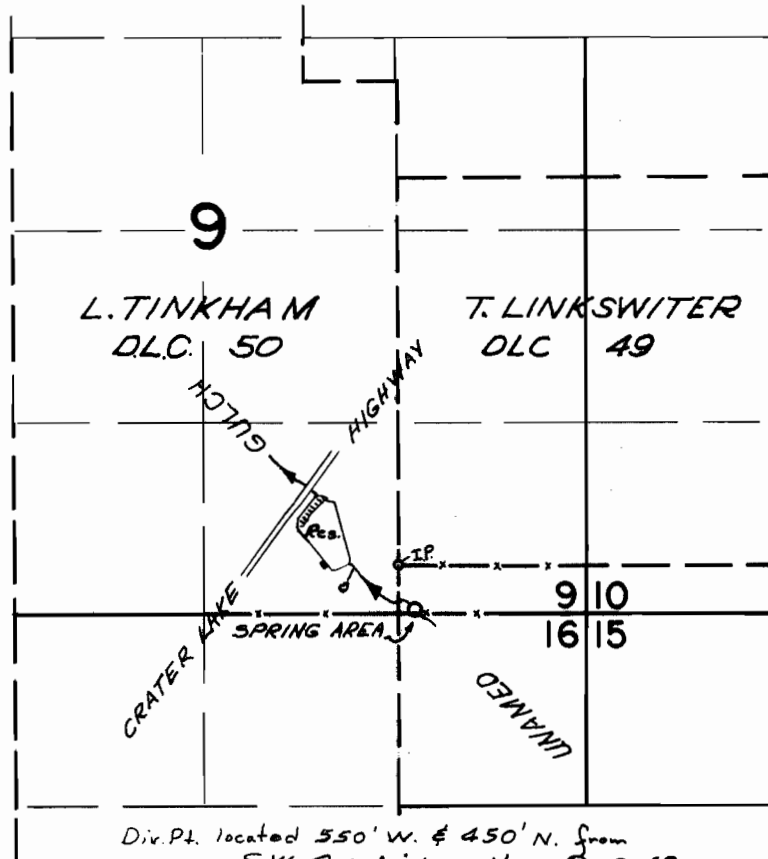

FINAL PROOF SURVEY UNDER

39680 29533
Application No. ~~P-39681~~ Permit No. ~~P-3965~~
IN NAME OF

GERALD W. & ROSIE MAYES

Surveyed JUNE 1, 1966, by V. GARNER