


T.37S.R.1W.W.M.

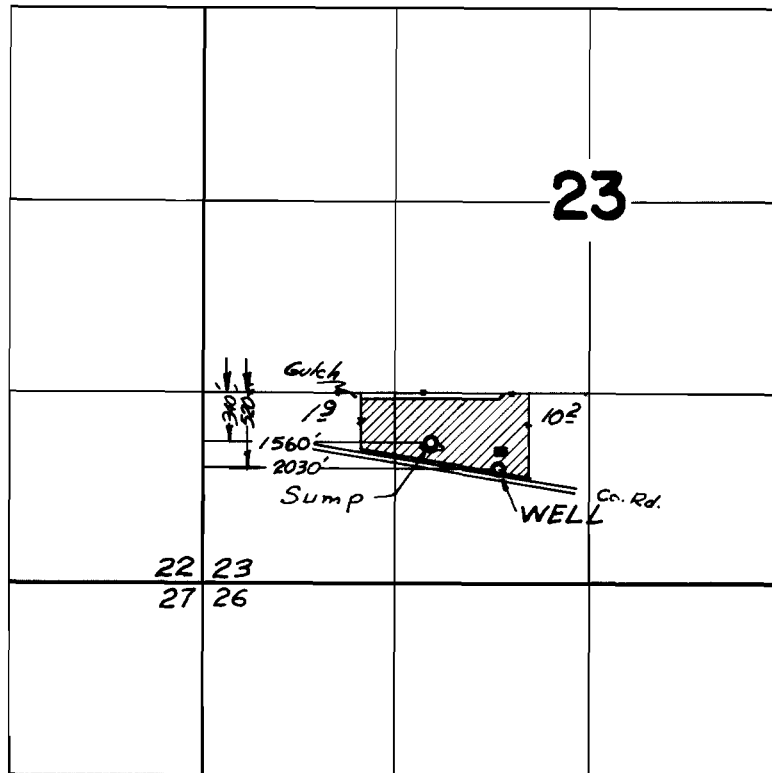

FINAL PROOF SURVEY UNDER

Application No. G-2981 Permit No. G-2767
IN NAME OF

A. N. NAPOLITANO

Surveyed July 21 1966, by V. GARNER