


# T.35 S.R.1 W. W.M.

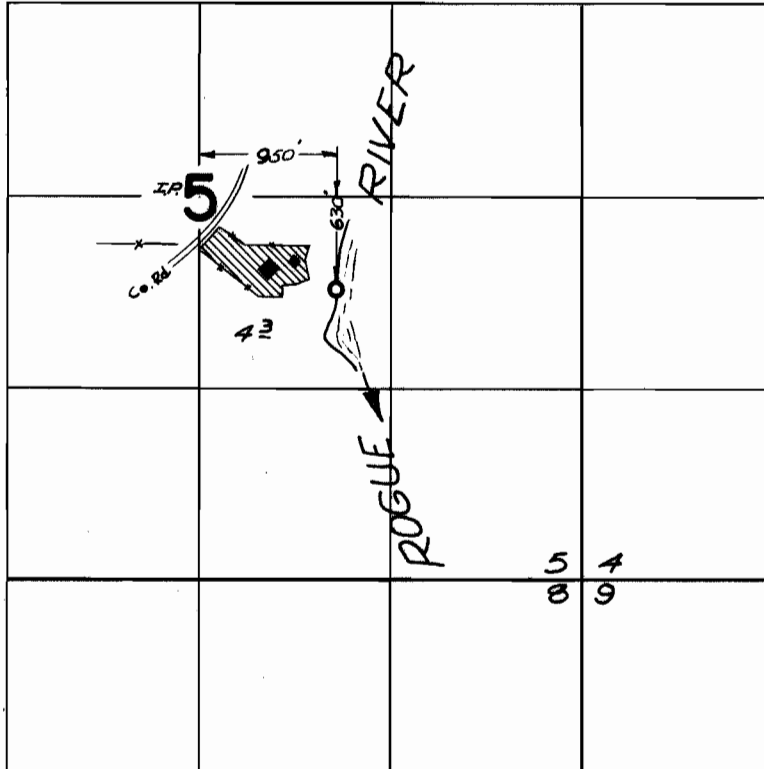

## FINAL PROOF SURVEY UNDER

Application No. 38242.. Permit No. 28488..  
IN NAME OF

*ROY D. and MARGARET E. WILSON*

Surveyed July..12., 1966., by *V. GARNER*.....