


T.21S.R.2E.W.M.

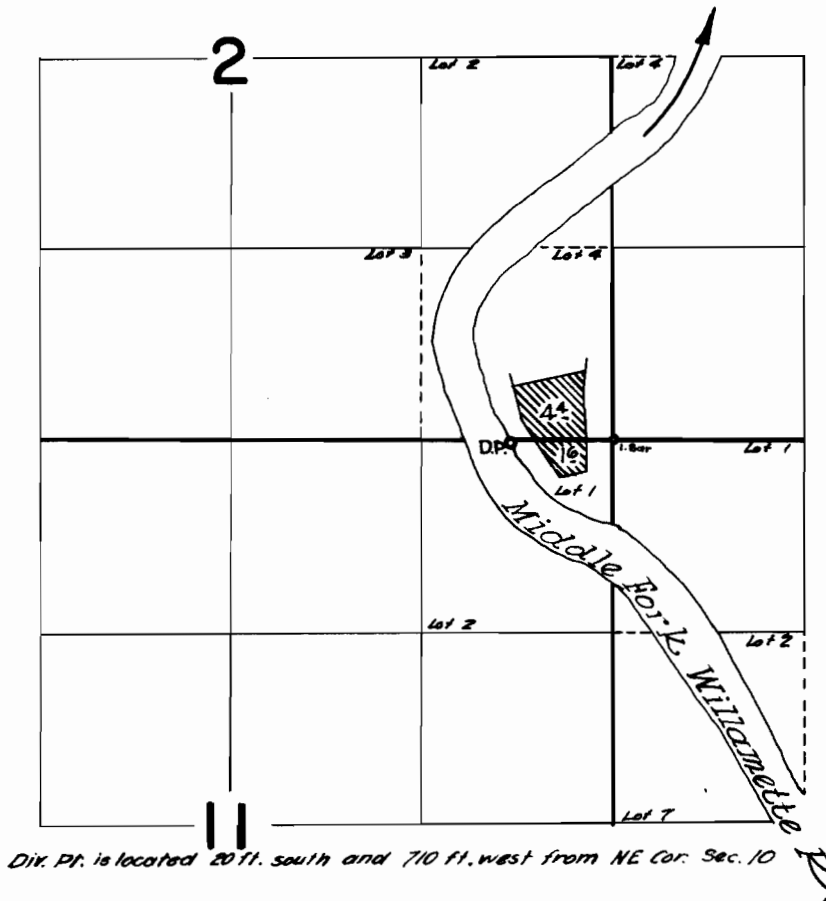

FINAL PROOF SURVEY
UNDER

Application No. 34120..... Permit No. 26993.....
IN NAME OF

WILLAMETTE NATIONAL FOREST

Surveyed April 28 1965, by *R. Jackson*