


T. 26 S. R. 46 E. W.M.

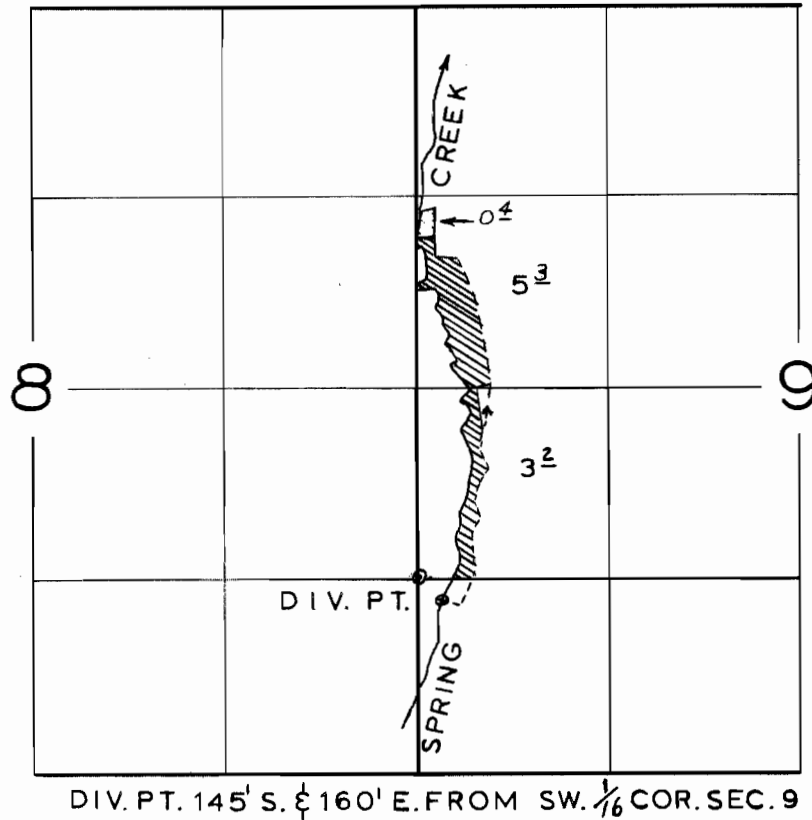

FINAL PROOF SURVEY
UNDER

Application No. 37530 Permit No. 27969
IN NAME OF

MAUDE H. GREELEY AND GREELEY RANCH PARTNERSHIP

Surveyed OCT. 28, 1966, by F. ELFERING