


T.14 S.R. 39 E.W.M.

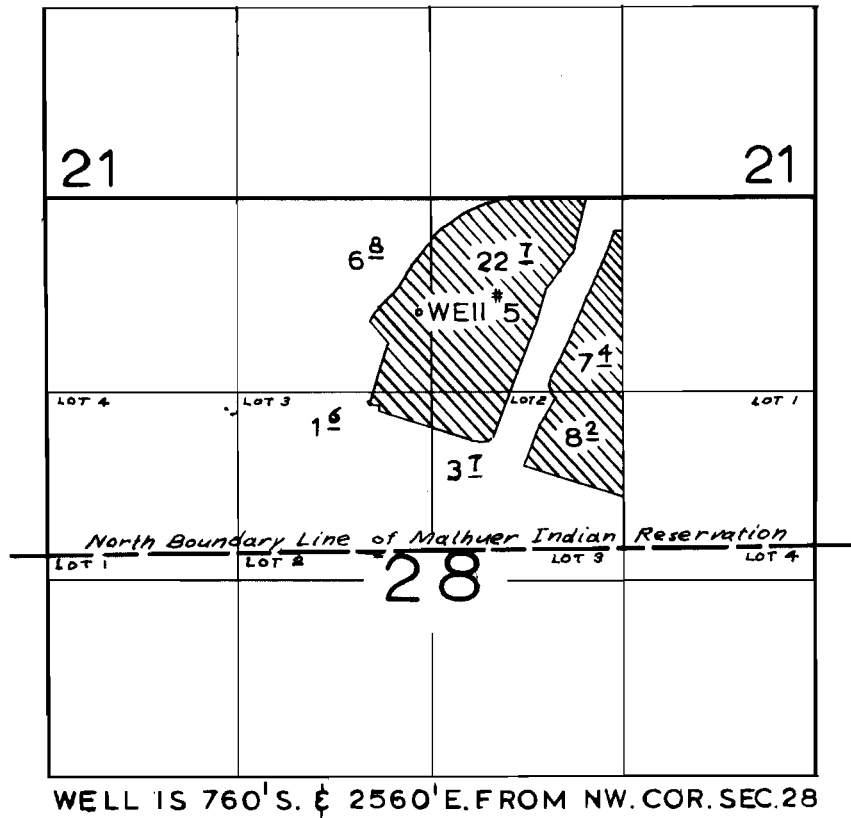

FINAL PROOF SURVEY
UNDER

Application No. G-2286 Permit No. G-2251
IN NAME OF

JOHN MOLTHAN

Surveyed OCT. 21 1966, by F. ELFERING