


T.2S.R.38E.W.M,

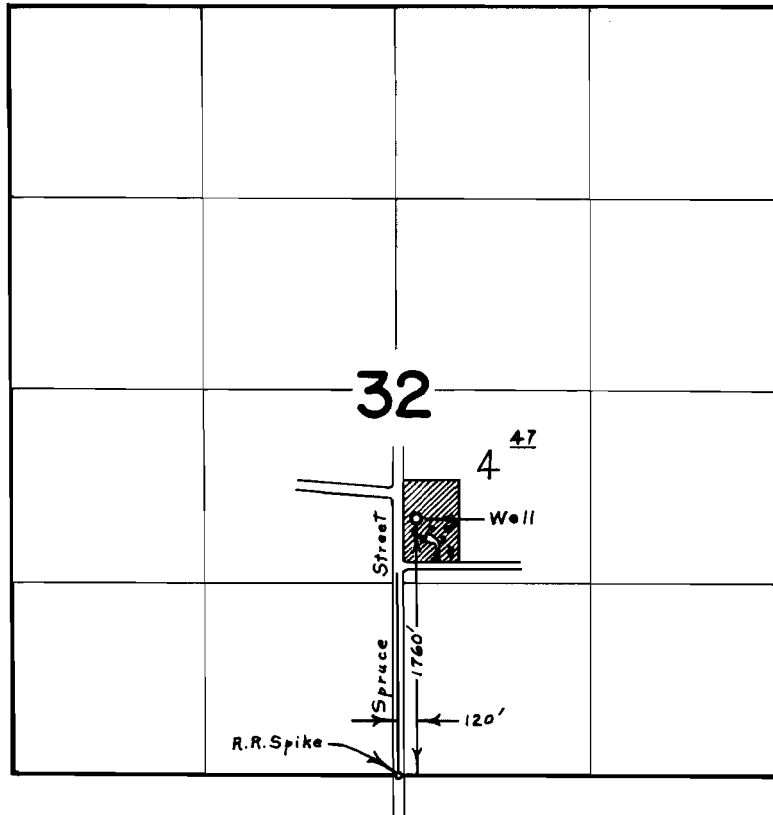

FINAL PROOF SURVEY
UNDER

Application No. G-3201 Permit No. G-3022
IN NAME OF

MRS. FRANKIE EVERS

Surveyed Oct. 27, 1966, by L. E. Gould