
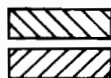


T.2S.R.38E.W.M.

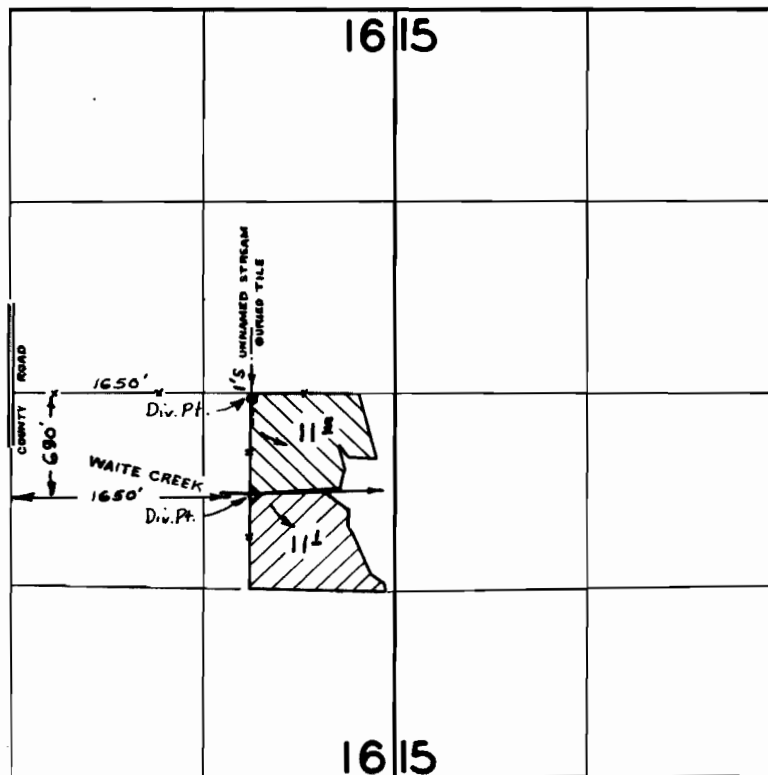

FROM UNNAMED STREAM

FROM WAITE CREEK

FINAL PROOF SURVEY
UNDER

Application No. 33157 Permit No. 26213
IN NAME OF

LEO W. WAITE

Surveyed Oct. 29 1965, by C. GARDNER