


T. 3 S. R. 45 E. W.M.

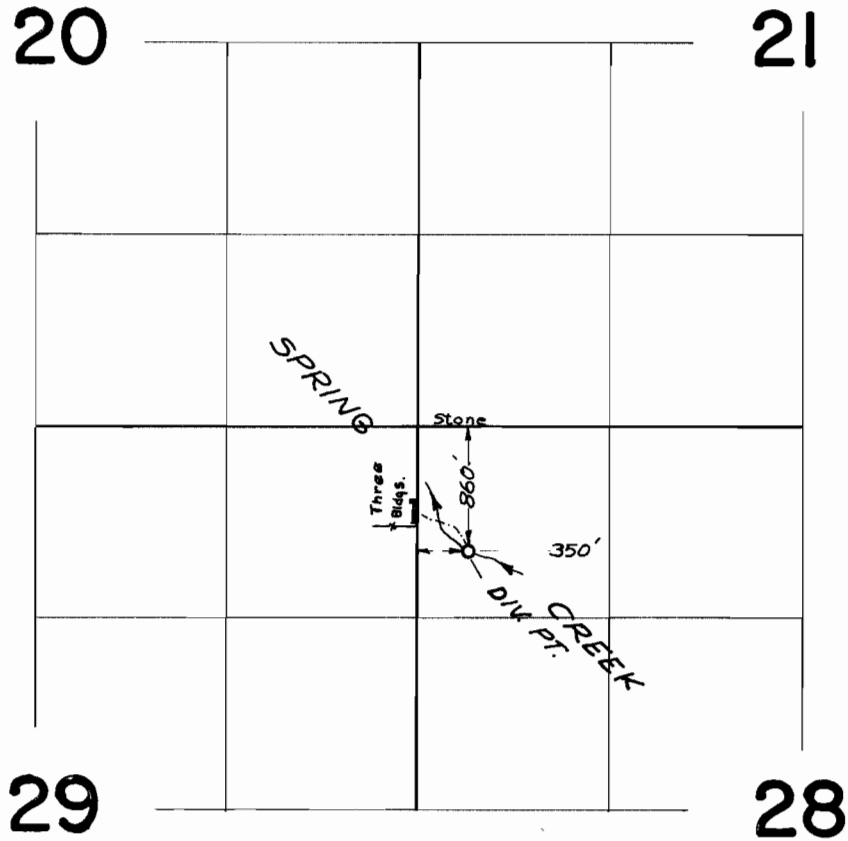

FINAL PROOF SURVEY UNDER

Application No. 31486 Permit No. 24821
IN NAME OF

HAVEN T. BENSON

Surveyed June 21, 1966, by V. GARNER