


T.2S. R.45E. W.M.

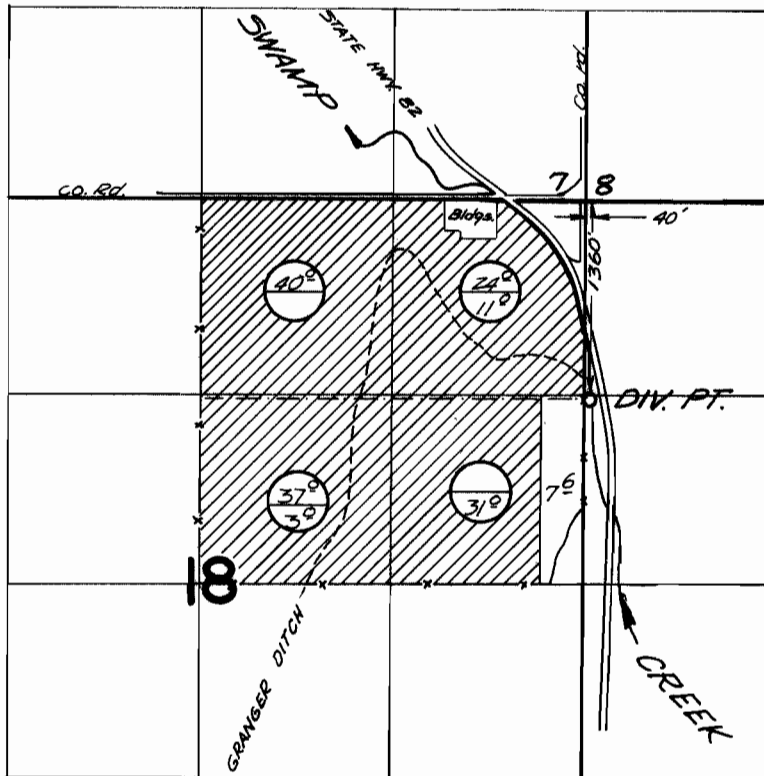

○ Supp.
— Primary.

FINAL PROOF SURVEY UNDER

Application No. 38687 Permit No. 28792
IN NAME OF

J.A. "BERT" EGGLESON FARMS, INC.

Surveyed June 29 1966, by V. GARNER