


T. 2 S. R. 44 E. W. M.

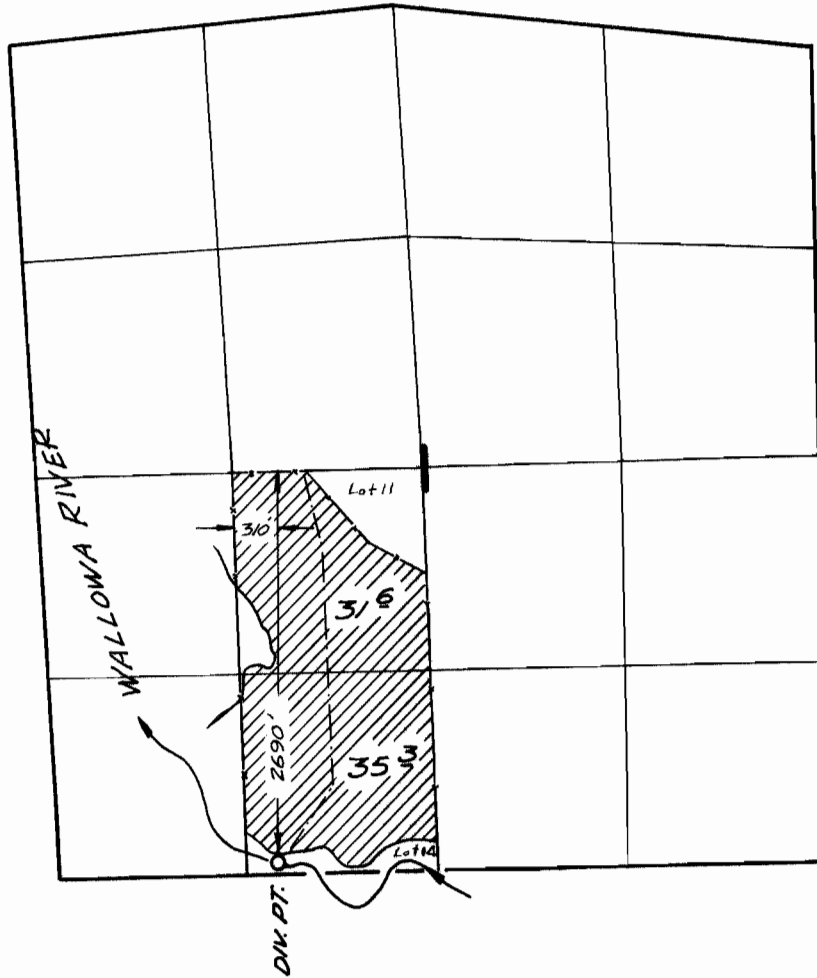

FINAL PROOF SURVEY
UNDER

Application No. 38943 Permit No. 29004
IN NAME OF

C. E. MCCREADY and RUBY MCCREADY

Surveyed June 29 1966, by V. GARNER