


T.4S.R.5 W.W.M.

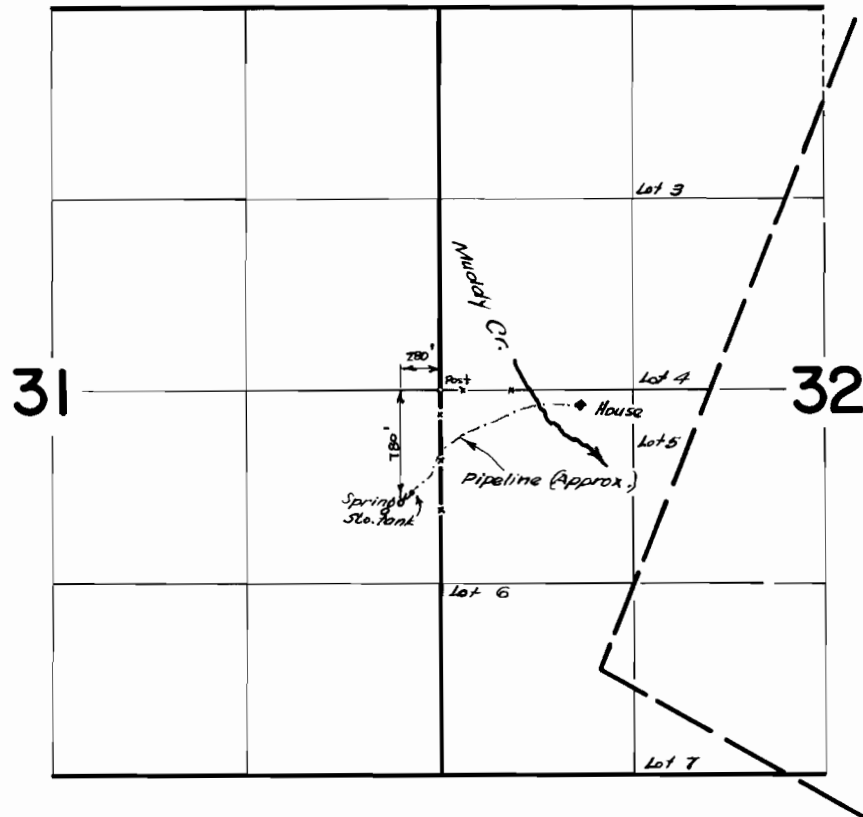

FINAL PROOF SURVEY
UNDER

Application No. **37406** Permit No. **27934**
IN NAME OF

HARRY E. CHASE

Surveyed *July 27 1965*, by

H Jackson