


T.22S. R.8W. W.M.

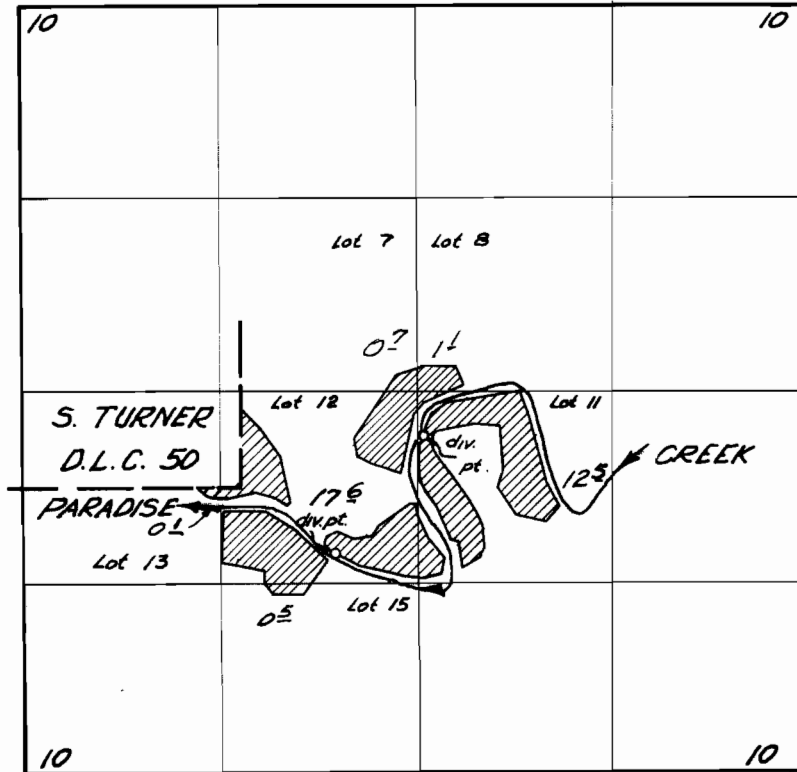

FINAL PROOF SURVEY UNDER

Application No. 25256 Permit No. 19841
IN NAME OF

SIDNEY GATES

Surveyed July 14 1956, by C.O. Bartels